

New Location
 Drill Deeper
 Abandonment

Company VIRGINIAN GASOLINE & OIL CO.
 Address CHARLESTON, WVA.
 Farm JOHN G. SHIRKEY HEIRS
 Tract _____ Acres 90 Lease No. 898
 Well (Farm) No. 7 Serial No. 3031
 Elevation (Spirit Level) 619.
 Quadrangle CLENDENIN
 County KANAWHA District ELK
 Engineer [Signature]
 Engineer's Registration No. 662
 File No. 68-63 Drawing No. _____
 Date 9-4-48 Scale 1"=660'

STATE OF WEST VIRGINIA
 DEPARTMENT OF MINES
 OIL AND GAS DIVISION
 CHARLESTON

WELL LOCATION MAP
 FILE NO. KAN-531-A

+ Denotes location of well on United States Topographic Maps, scale 1 to 62,500, latitude and longitude lines being represented by border lines as shown.
 - Denotes one inch spaces on border line of original tracing.

6-0 217

Elk District, Kanawha County, W. Va.

By Virginian Gasoline & Oil Co., Box 1273, Charleston, 25, W. Va.

Abandoned under permit Kan-.....-A?

On 90 acres, on Indian Creek.

Elevation, 619' L.

Minerals owned by W. F. Shirkey et al., 402 Columbia Blvd., Charleston, W. Va.

Drilling commenced March 14, 1913; completed April 22, 1913.

Date of shot not shown.

Oil, 5 bbls., 1st 24 hrs.

Salt water at 808'.

10" casing, 32'; 8 $\frac{1}{4}$ " , 365' (pulled); 6 $\frac{3}{8}$ " , 1400'.

Coal was encountered at 40-44 and 195-197'.

Oil well. Abandonment reported to Dept. of Mines Sept. 7, 1948.

Record to RCT from Mrs. Griffith Jan. 5, 1949. Old File No. 1341.

	Top.	Bottom.
Clay	0 -	32
Slate	32 -	40
Coal	40 -	44
Slate	44 -	100
Sand	100 -	120
Slate	120 -	195
Coal	195 -	197
Slate	197 -	260
Sand	260 -	300
Slate	300 -	325
Sand	325 -	365
Slate	365 -	500
Sand	500 -	535
Slate	535 -	570
Sand	570 -	610
Slate	610 -	615
Sandy lime	615 -	655
Slate and shells	655 -	675
Salt Sand (water, 808')	675 -	1213
Slate	1213 -	1215
Sandy lime	1215 -	1283
Nexton Sand	1283 -	1314
Slate	1314 -	1317
Sandy lime	1317 -	1334
Slate	1334 -	1339
Little Lime	1339 -	1370
Slate	1370 -	1374
Lime	1374 -	1380
Slate	1380 -	1383
Pink lime	1383 -	1390
Pencil Cave	1390 -	1397
Big Lime	1397 -	1530
Keener Sand	1530 -	1557
Red rock	1557 -	1567
Sand	1567 -	1585
Slate and shells	1585 -	1638
Sand (oil and gas, 1638')	1638 -	1648
Slate	1648 -	1650
Sand (oil, 1656')	1650 -	1656
Slate and shells	1656 -	1740
Weir Sand (oil-gas show, 1742-1793')	1740 -	1795
Slate and shells	1795 -	1841
Total depth		1841



Completed no inspection
1341

STATE OF WEST VIRGINIA
DEPARTMENT OF MINES
OIL AND GAS DIVISION

WELL RECORD

Permit No. 531-A

Oil or Gas Well Oil
(KIND)

Abandonment


Company VIRGINIAN GASOLINE & OIL CO.
 Address P.O. Box 1273, Charleston 25, W. Va.
 Farm M. J. Shirkey Acres 90
 Location (waters) Indian Creek
 Well No. 3031 Elev. 619.
 District Elk County Kanawha
 The surface of tract is owned in fee by _____
 Address _____
 Mineral rights are owned by W. F. Shirkey et al
402 Columbia Blvd. Address Charleston, W. Va.
 Drilling commenced 3-14-13
 Drilling completed 4-22-13
 Date Shot Not Shown From _____ To _____
 With Not Given
 Open Flow /10ths Water in _____ Inch
 /10ths Merc. in _____ Inch
 Volume _____ Cu. Ft.
 Rock Pressure _____ lbs. _____ hrs.
 Oil 5 bbls., 1st 24 hrs.
 Fresh water _____ feet _____ feet
 Salt water 808 feet _____ feet

Casing and Tubing	Used in Drilling	Left in Well	Packers
Size			Kind of Packer
16			
13			
10	32	32	Size of
8 1/4	365	Pulled	
6 5/8	1400	1400	Depth set
5 3/16			
3			Perf. top
2			Perf. bottom
Liners Used			Perf. top
			Perf. bottom


CASING CEMENTED _____ SIZE _____ No. Ft. _____ Date _____

COAL WAS ENCOUNTERED AT 40 FEET 48 INCHES
195 FEET 24 INCHES FEET INCHES
 FEET INCHES FEET INCHES

Formation	Color	Hard or Soft	Top	Bottom	Oil, Gas or Water	Depth Found	Remarks
Clay				32			
Slate			32	40			
Coal			40	44			
Slate			44	100			
Sand			100	120			
Slate			120	195			
Coal			195	197			
Slate			197	260			
Sand			260	300			
Slate			300	325			
Sand			325	365			
Slate			365	500			
Sand			500	535			
Slate			535	570			
Sand			570	610			
Slate			610	615			
Sandy Lime			615	655			
Slate & Shells			655	675			
Salt Sand			675	1213	Water	808'	
Slate			1213	1215			
Sandy Lime			1215	1283			
Maxon Sand			1283	1314			
Slate			1314	1317			
Sandy Lime			1317	1334			
Slate			1334	1339			
Little Lime			1339	1370			
Slate			1370	1374			
Lime			1374	1380			
Slate			1380	1383			
Pink Lime			1383	1390			
Pencil Cave			1390	1397			
Big Lime			1397	1530			
Keener Sand			1530	1557			
Red Rock			1557	1567			
Sand			1567	1585			
Slate & Shells			1585	1638	Oil & Gas	1638'	
Sand			1638	1648			
Slate			1648	1650			
Sand			1650	1656	Oil	1656'	

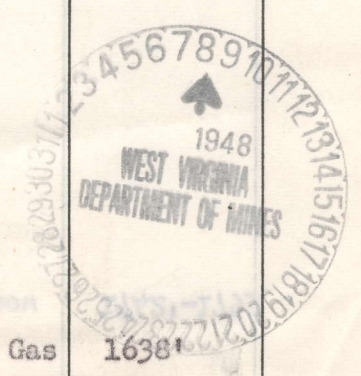

Formation	Color	Hard or Soft	Top	Bottom	Oil, Gas or Water	Depth Found	Remarks
Slate & Shells			1656	1740			
Weir Sand (Oil)			1740	1795	Oil Gas Show	1742'-1793'	
Slate & Shells			1795	1841			
Total Depth			1841	1841			

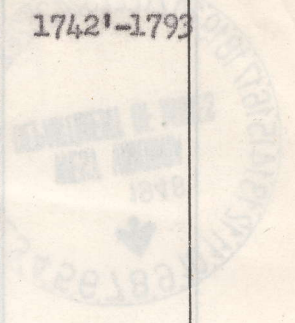

WEST VIRGINIA DEPARTMENT OF MINES

DEPARTMENT OF MINES STATE OF WEST VIRGINIA

Date September 7, 1910

APPROVED VIRGINIAN GASOLINE & OIL CO., Owner

By J. H. Moore Chief Engineer (Title)