


Latitude 38° 25'

Longitude 81° 25'

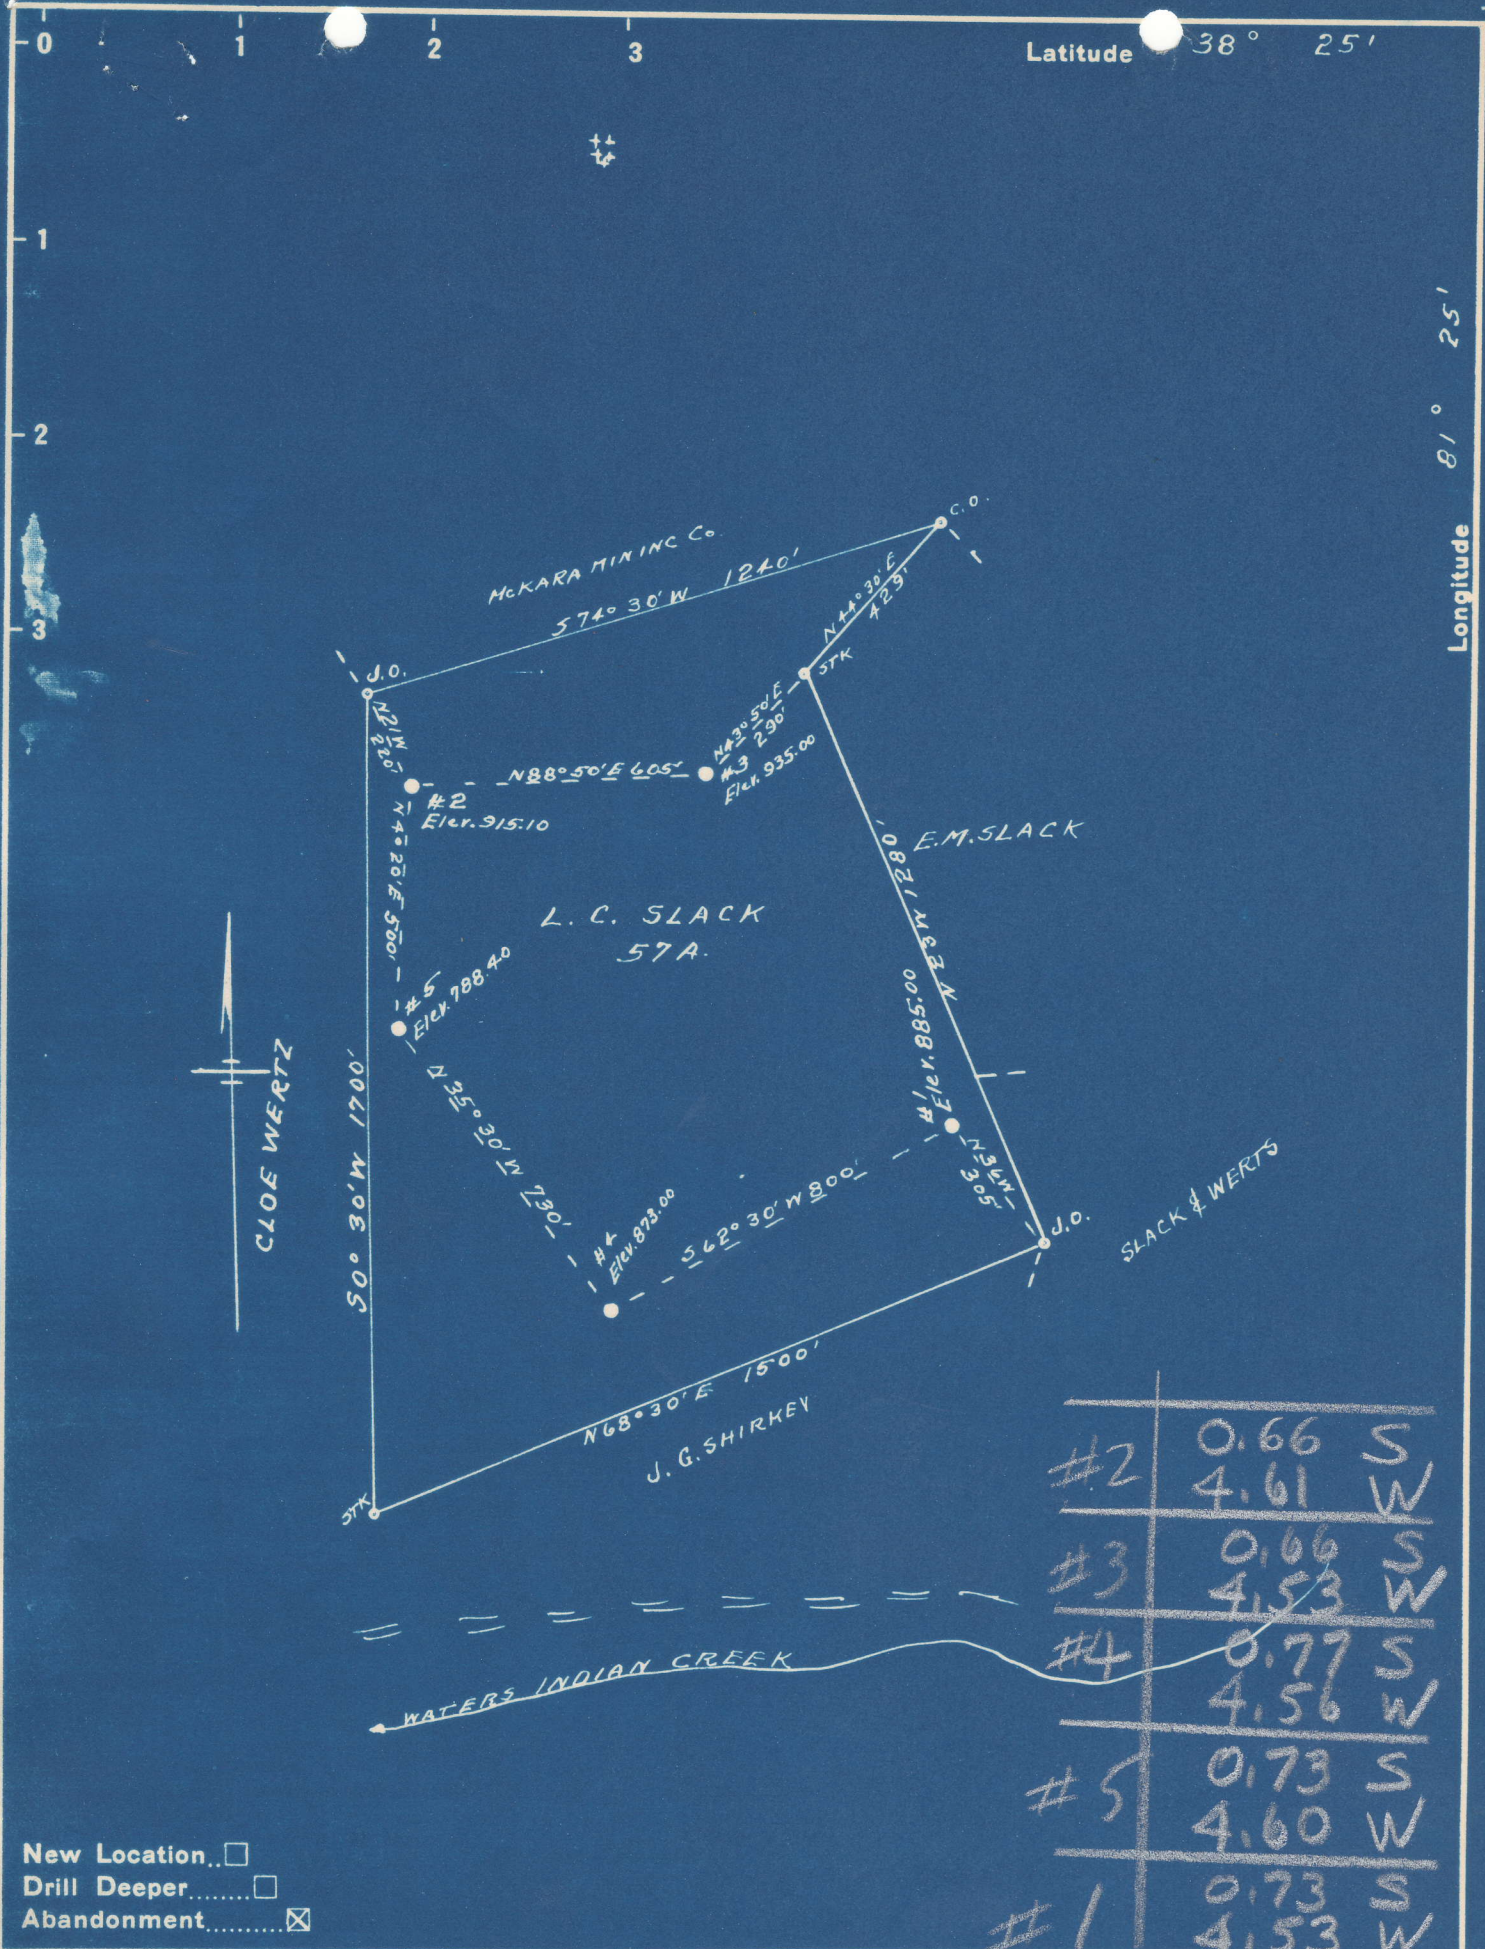

New Location
 Drill Deeper
 Abandonment

Company OKMULGEE SUPPLY CORP.
 Address BOX 311, OKMULGEE, OKLA.
 Farm L. C. SLACK
 Tract _____ Acres 5.7 Lease No. _____
 Well (Farm) No. 1-2-3-4-5 Serial No. _____
 Elevation (Spirit Level) SEE ABOVE
 Quadrangle CLENDENNIN
 County KANAWHA District ELK
 Engineer L. F. Dye
 Engineer's Registration No. 804
 File No. _____ Drawing No. _____
 Date 7-22-48 Scale 1" = 400'

STATE OF WEST VIRGINIA
 DEPARTMENT OF MINES
 OIL AND GAS DIVISION
 CHARLESTON

WELL LOCATION MAP
 FILE NO. KAN-527-A-#2
KAN-536-A KAN-530-A-#3
#1 KAN-533-A-#4
KAN-535-A-#5
 + Denotes location of well on United States Topographic Maps, scale 1 to 62,500, latitude and longitude lines being represented by border lines as shown.
 - Denotes one inch spaces on border line of original tracing.

60 217