


Latitude 38° 25'

Longitude 81° 25'

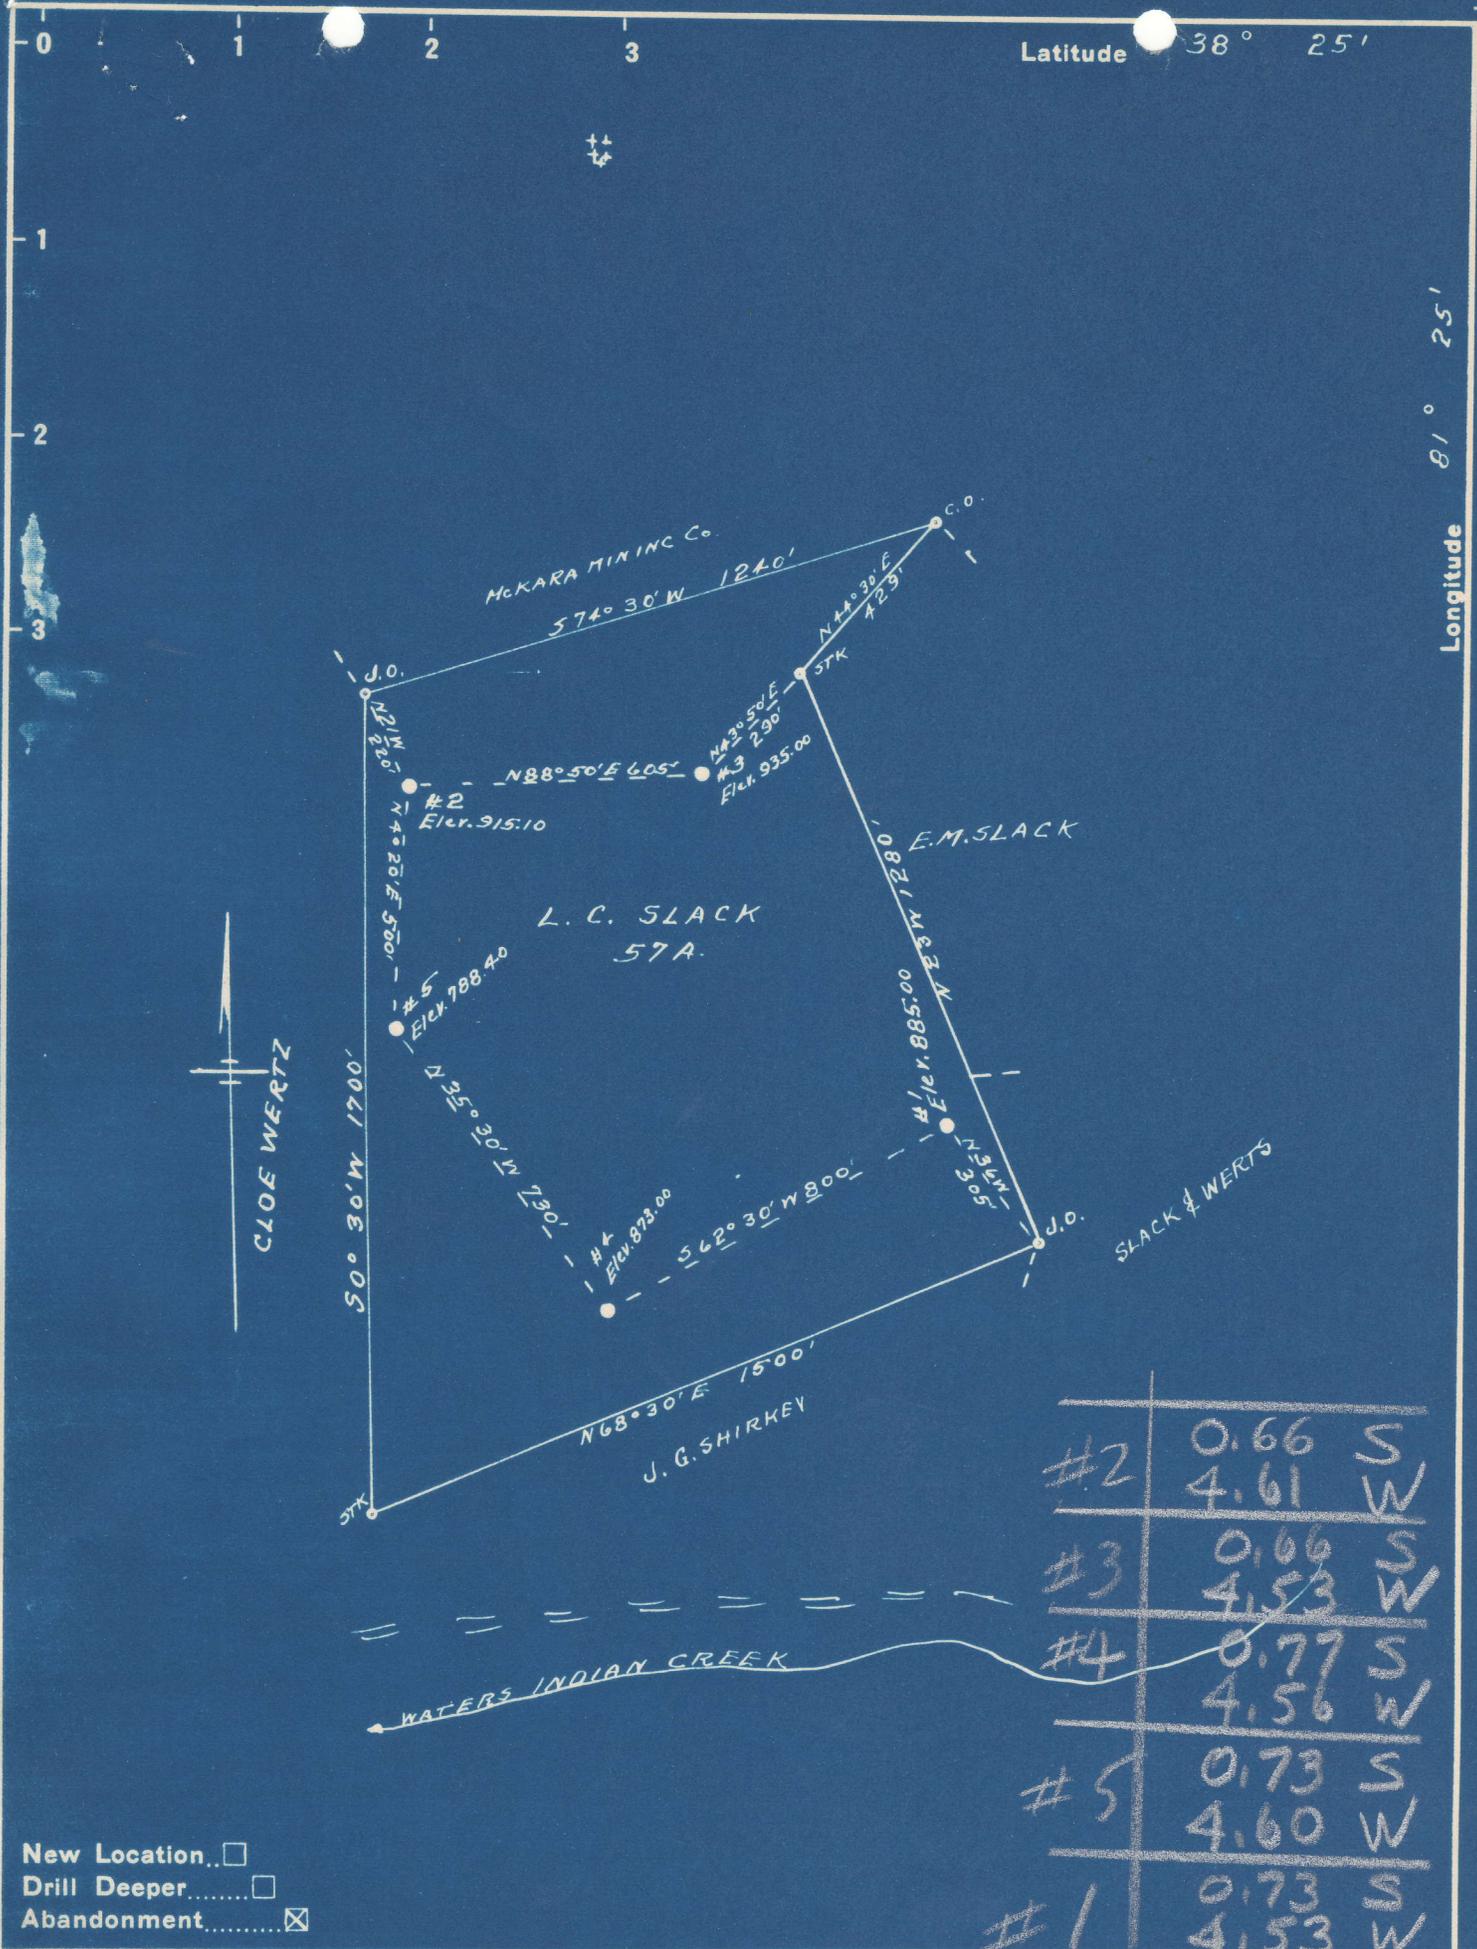

| | | |
|----|--------|--------|
| #2 | 0.66 S | 4.61 W |
| #3 | 0.66 S | 4.53 W |
| #4 | 0.77 S | 4.56 W |
| #5 | 0.73 S | 4.60 W |
| #1 | 0.73 S | 4.53 W |

New Location
 Drill Deeper
 Abandonment

Company OKMULGEE SUPPLY CORP.
BOX 3111
 Address OKMULGEE, OKLA.
 Farm L.C. SLACK
 Tract _____ Acres 57 Lease No. _____
 Well (Farm) No. 1-2-3-4-5 Serial No. _____
 Elevation (Spirit Level) SEE ABOVE
 Quadrangle CLENDENNIN
 County KANAWHA District ELK
 Engineer L. F. Dye
 Engineer's Registration No. 804
 File No. _____ Drawing No. _____
 Date 7-22-48 Scale 1" = 400'

STATE OF WEST VIRGINIA
 DEPARTMENT OF MINES
 OIL AND GAS DIVISION
 CHARLESTON

WELL LOCATION MAP
 KAN-527-A-#2
 FILE NO. KAN-530-A-#3
 KAN-536-A KAN-533-A-#4
 #1 KAN-535-A-#5
 + Denotes location of well on United States Topographic Maps, scale 1 to 62,500, latitude and longitude lines being represented by border lines as shown.
 - Denotes one inch spaces on border line of original tracing.

60 217

L. C. SLACK NO. 1 WELL.

536A

Elk District, Kanawha County, W. Va.

By Okmulgee Supply Corp., Box 911, Okmulgee, Okla.

Abandoned under permit Kan-----A?

On.....acres.

Elevation,' L.

Shot Nov. 12, 1912, at 1948-1963'; and Apr. 16, 1914, at 2103-2109'.

Date of completion not given.

8 5/8" casing, 505'; 7", 1720'; all left in.

Oil well. Record to Sept. of Mines not dated or stamped.

Record to RCT from Mrs. Griffith Jan. 5, 1949. Old File No. 1343.

| | Top. | Bottom. |
|-------------|-------|---------|
| Coal | 420 | - 425 |
| Salt Sand | 1005? | - 1485 |
| Maxton Sand | 1487 | - 1585 |
| Big Lime | 1678 | - 1818 |
| Squaw Sand | 1948 | - 1955 |
| Weir Sand | 2084 | - 2109 |
| Total depth | | 2112 |



Completed No Inspection

1343

STATE OF WEST VIRGINIA
DEPARTMENT OF MINES
OIL AND GAS DIVISION

WELL RECORD

Permit No. 536A

Oil or Gas Well _____
(KIND)

Company OKMULGEE SUPPLY CORP.
 Address Box 911 - Okmulgee, Okla.
 Farm L. C. Slack No. Acres _____
 Location (waters) _____
 Well No. No. 1 Elev. _____
 District Blk County Kanawha
 The surface of tract is owned in fee by _____
 Address _____
 Mineral rights are owned by _____
 Address _____

| Casing and Tubing | Used in Drilling | Left in Well | Packers |
|-------------------|------------------|--------------|----------------------|
| Size | | | |
| 16 | | | Kind of Packer _____ |
| 18 | | | Size of _____ |
| 10 | | | Depth set _____ |
| 5 8/16 | 505' | 505' | Perf. top _____ |
| 5 7/8 7" | 1720' | 1720' | Perf. bottom _____ |
| 5 3/16 | | | Perf. top _____ |
| 3 | | | Perf. bottom _____ |
| 2 | | | Perf. top _____ |
| Liners Used | | | Perf. bottom _____ |

Drilling commenced _____
 Drilling completed _____
 Date Shot 11-12-12 From 1948 To 1963
 With 4-16-14 2103 2109
 Open Flow /10ths Water in _____ Inch
 /10ths Merc. in _____ Inch
 Volume _____ Cu. Ft.
 Rock Pressure _____ lbs. _____ hrs.
 Oil _____ bbls., 1st 24 hrs.
 Fresh water _____ feet _____ feet
 Salt water _____ feet _____ feet

CASING CEMENTED _____ SIZE _____ No. Ft. _____ Date _____
 COAL WAS ENCOUNTERED AT _____ FEET _____ INCHES
 _____ FEET _____ INCHES FEET _____ INCHES
 _____ FEET _____ INCHES FEET _____ INCHES

| Formation | Color | Hard or Soft | Top | Bottom | Oil, Gas or Water | Depth Found | Remarks |
|-----------------|-------|--------------|----------------|----------------|-------------------|-------------|---------|
| Coal | | | 420 | 425 | | | |
| Salt Sand | 1905 | | 1005 | 1485 | | | |
| Maxon Sand | | | 1487 | 1585 | | | |
| Big Line | | | 1678 | 1818 | | | |
| Squaw Sand | | | 1948 | 1955 | | | |
| Weir Sand | | | 2084 | 2109 | | | |
| Total Depth | | | | 2112 | | | |

(C)

