


Latitude 38° 30'

Longitude 81° 25'

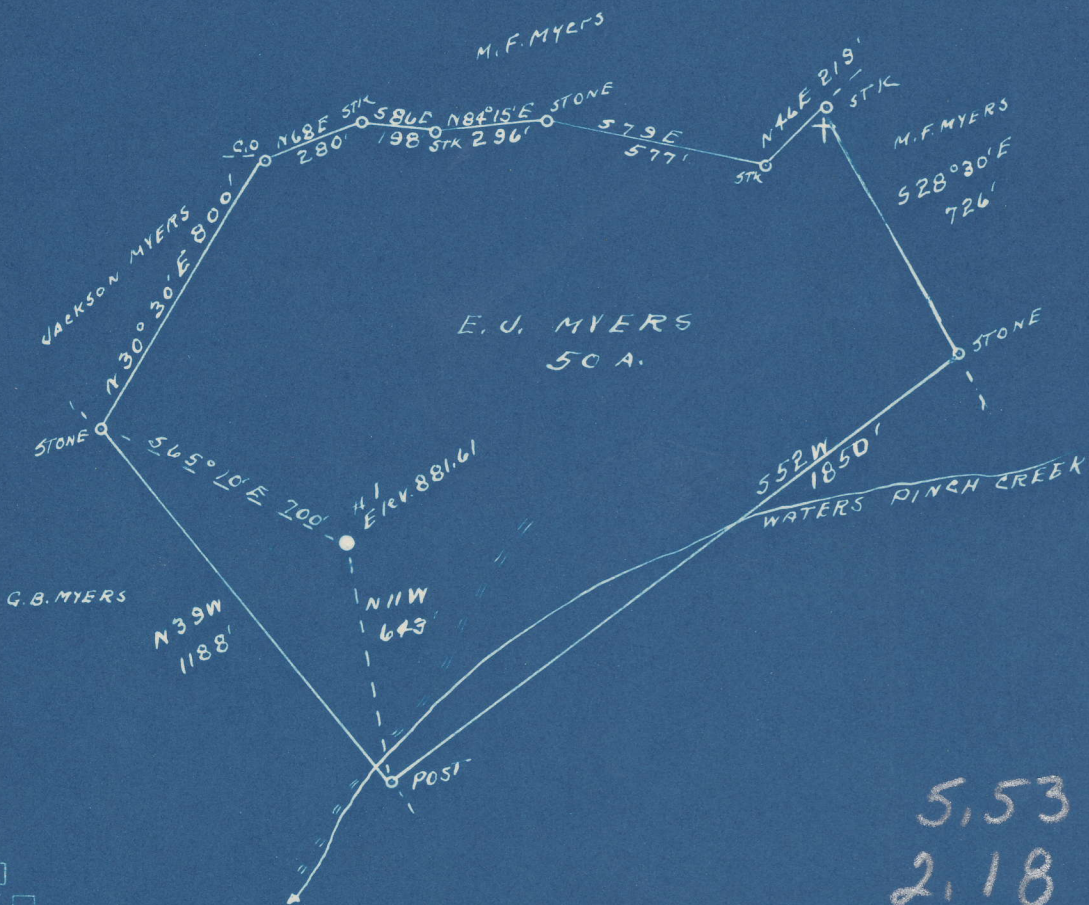

New Location   
 Drill Deeper   
 Abandonment

Company EVERITT - WHITING INC.

Address OKEMAH, OKLA.

Farm E. J. MYERS

Tract \_\_\_\_\_ Acres 50 Lease No. \_\_\_\_\_

Well (Farm) No. 1 Serial No. \_\_\_\_\_

Elevation (Spirit Level) 881.61

Quadrangle CLENDENIN

County KANAWHA District ELK

Engineer L. F. Rye

Engineer's Registration No. 804

File No. \_\_\_\_\_ Drawing No. \_\_\_\_\_

Date 1-17-49 Scale 1" = 500'

STATE OF WEST VIRGINIA  
 DEPARTMENT OF MINES  
 OIL AND GAS DIVISION  
 CHARLESTON

**WELL LOCATION MAP**  
 FILE NO. KAN-597-A

+ Denotes location of well on United States Topographic Maps, scale 1 to 62,500, latitude and longitude lines being represented by border lines as shown.

- Denotes one inch spaces on border line of original tracing.

6-0 217



E. J. MYERS NO. 1 WELL.

597A

Elk District, Kanawha County, W. Va.  
By Everitt-Whiting, Inc., Okemah, Okla.  
Abandoned under permit Kan-.....-A?  
On 50 acres.

Elevation, 881.61' L.

Drilling completed May 30, 1913.

Shot May 30, 1913, at 2007', with 20 qts.; March 23, 1916, at  
1986-2014', with 40 qts.

8 5/8" casing, 474'; 7" C. D., 1688'; 2" tubing, 2060'; all left in.

Oil well. Record to Dept. of Mines stamped Jan. 28, 1949.

Record to RCT from Mrs. Griffith May 21, 1949. Old File No. 1388.

	Top.	Bottom.
Coal	350	354
Coal	415	419
Coal	450	454
Coal	469	474
Salt Sand	965	1455
Sand	1460	1540
Big Lime	1650	1805
Big Injun Sand (gas, 1810')	1805	1830
Squaw Sand	1912	1922
Weir Sand (oil, 2000-2008')	1983	2062
Total depth		2062





Completed no inspection

1388

STATE OF WEST VIRGINIA DEPARTMENT OF MINES OIL AND GAS DIVISION

WELL RECORD

Permit No. 597-A Oil or Gas Well (KIND)

Company Everitt - Whiting, Inc., Address Okemah, Okla. Farm E. J. Myers Acres 50 Well No. Elk 1 Elev. 881.61' District Elk County Kanawha

Table with columns: Casing and Tubing, Used in Drilling, Left in Well, Packers. Includes rows for size (16, 13, 10), 8 1/8 - 5/8", 6 5/8 7" OD, 5 3/16, 3, 2, and Liners Used.

CASING CEMENTED SIZE No. Ft. Date COAL WAS ENCOUNTERED AT FEET INCHES FEET INCHES FEET INCHES

Main well log table with columns: Formation, Color, Hard or Soft, Top, Bottom, Oil, Gas or Water, Depth Found, Remarks. Includes formations like Coal, Salt Sand, Big Lime, etc., and a SHOT RECORD section.

