


Latitude 38 30

Longitude 81 20

JOHN SLACK HRS.

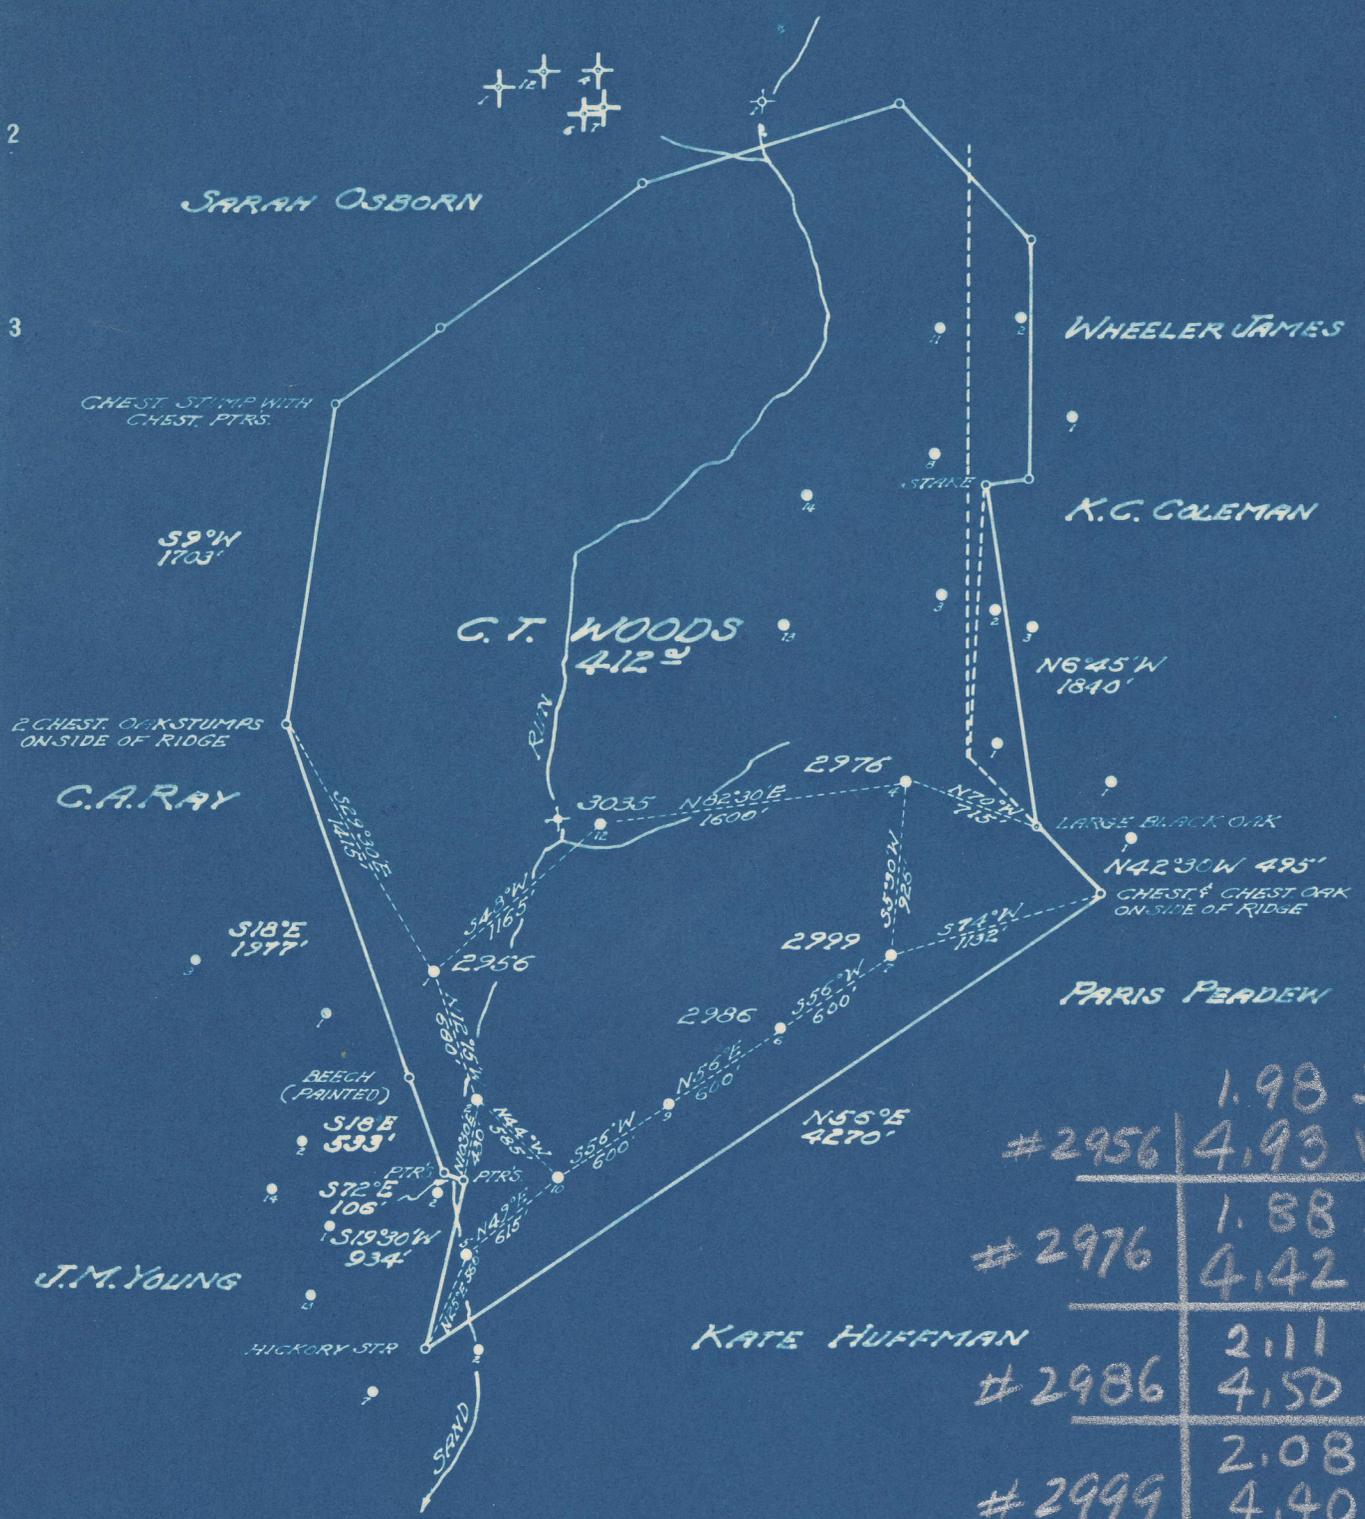

	1.98 S
#2956	4.93 W
#2976	1.88 S
	4.42 W
#2986	2.11 S
	4.50 W
#2999	2.08 S
	4.40 W
#3035	1.89 S
	4.71 W

- New Location
- Drill Deeper
- Abandonments

Company UNITED FUEL GAS CO.
 Address CHARLESTON, WVA.
 Farm G.T. WOODS
 Tract _____ Acres 412 Lease No. 580
 Well (Farm) No. 14,6712 Serial No. 3035-2986-2999
 Elevation (Spirit Level) 1-823, 4-824, 5-1047
 Quadrangle CLENDENIN
 County KANAWHA District BIG SANDY
 Engineer W.A. MOORE NC
 Engineer's Registration No. 662
 File No. 72-67 Drawing No. _____
 Date 3-30-49 Scale 1"=1000'

STATE OF WEST VIRGINIA
 DEPARTMENT OF MINES
 OIL AND GAS DIVISION
 CHARLESTON

WELL LOCATION MAP

FILE NO. KAN-621-A-#2956
KAN-622-A-#2976
KAN-623-A-#2986
KAN-624-A-#2999

+ Denotes location of well on United States Topographic Maps, scale 1 to 62,500, latitude and longitude lines being represented by border lines as shown.

- Denotes one inch spaces on border line of original tracing.

6-0-717

Big Sandy District, Kanawha County, W. Va.

By United Fuel Gas Co., Box 1273, Charleston, 25, W. Va.

Abandoned under permit Kan-.....-A?

On 412 acres, on Sand Run of Elk River.

Elevation, 764' L.

Minerals owned by Myrtle W. Hall, 1500 Kanawha Blvd., Charleston, W. Va.

Drilling commenced March 21, 1913; completed April 25, 1913.

Date shot, not given.

Oil, 125 bbls., 1st 24 hrs.

10" casing, 41'; 8 $\frac{1}{4}$ " , 640' (pulled); 6 $\frac{5}{8}$ " , 1553'; 2" tubing, 1846'.

Oil well. Record to Dept. of Mines dated April 12, 1949.

Record to RCT from Mrs. Griffith September 27, 1949. Old File No. 1408.

	Top.	Bottom.
Clay	0	10
Sand	10	200
Slate	200	225
Sand	225	600
Slate and shells	600	975
Salt Sand	975	1380
Red rock	1380	1400
Slate and shells	1400	1494
Little Lime	1494	1532
Break	1532	1536
Shells	1536	1541
Pencil Cave	1541	1547
Big Lime	1547	1677
Big Injun Sand	1677	1717
Slate and shells	1717	1835
Oil sand	1835	1846
Total depth		1846



STATE OF WEST VIRGINIA
DEPARTMENT OF MINES
OIL AND GAS DIVISION

1408

WELL RECORD
ABANDONMENT

Permit No. 625-A

Oil or Gas Well Oil
(KIND)

Company United Fuel Gas Company
Address P. O. Box 1273, Charleston 25, W. Va.
Farm C. T. Woods Acres 412
Location (waters) Sand Run of Elk River
Well No. 3035 Elev. 764
District Big Sandy County Kenawha
The surface of tract is owned in fee by _____
Address _____
Mineral rights are owned by Myrtle W. Hall
1500 Kan. Blvd. Address Chas., W. Va.
Drilling commenced 3-21-13
Drilling completed 4-25-13
Date Shot Not Given From _____ To _____
With _____
Open Flow _____ /10ths Water in _____ Inch
_____ /10ths Merc. in _____ Inch
Volume _____ Cu. Ft.
Rock Pressure _____ lbs. _____ hrs.
Oil 125 _____ bbls., 1st 24 hrs.
Fresh water _____ feet _____ feet
Salt water _____ feet _____ feet

Casing and Tubing	Used in Drilling	Left in Well	Packers
Size			
16			Kind of Packer
13			
10	41	41	Size of
8 1/4	640	Pulled	
6 5/8	1553	1553	Depth set
5 3/16			
3			Perf. top
2 Tubing		1846	Perf. bottom
Liners Used			Perf. top
			Perf. bottom

CASING CEMENTED _____ SIZE _____ No. Ft. _____ Date _____
COAL WAS ENCOUNTERED AT _____ FEET _____ INCHES
_____ FEET _____ INCHES FEET _____ INCHES
_____ FEET _____ INCHES FEET _____ INCHES

Formation	Color	Hard or Soft	Top	Bottom	Oil, Gas or Water	Depth Found	Remarks
Clay				10			
Sand			10	200			
Slate			200	225			
Sand			225	600			
Slate & Shells			600	975			
Salt Sand			975	1380			
Red Rock			1380	1400			
Slate & Shells			1400	1494			
Little Lime			1494	1532			
Break			1532	1536			
Shells			1536	1541			
Pencil Cave			1541	1547			
Big Lime			1547	1677			
Big Injun			1677	1717			
Slate & Shells			1717	1835			
Oil Sand			1835	1846			
Total Depth				1846'			

