



Company SAM BEREN  
 Address 514-4th. ST. MARIETTA, OHIO  
 Farm W. C. JARRETT  
 Tract \_\_\_\_\_ Acres 40.0 Lease No. 27207  
 Well (Farm) No. 1 Serial No. 3258  
 Elevation (Spirit Level) 709.8  
 Quadrangle CLENDENIN  
 County KANAWHA District ELK  
 Engineer G. E. Kiebe  
 Engineer's Registration No. No 9,  
 File No. \_\_\_\_\_ Drawing No. \_\_\_\_\_  
 Date 7-23-49 Scale 1" = 1320'

STATE OF WEST VIRGINIA  
 DEPARTMENT OF MINES  
 OIL AND GAS DIVISION  
 CHARLESTON

**WELL LOCATION MAP**  
 FILE NO. KAN-639-A

+ Denotes location of well on United States Topographic Maps, scale 1 to 62,500, latitude and longitude lines being represented by border lines as shown.

- Denotes one inch spaces on border line of original tracing.

6-0 2 11



W. C. JARRETT NO. 1 WELL.

546A?  
639A

Elk District, Kanawha County, W. Va.  
 By Strauss & Beren, Marietta, Ohio.  
 Abandoned under permit Kan-.....-A?  
 On 40 acres, on Blue Creek.  
 Elevation, 709.8' L.  
 Surface owned by W. C. Jarrett, Blue Creek, W. Va.  
 Drilling commenced May 11, 1916; completed June 13, 1916.  
 Shot June 16, 1916, with 150 qts.  
 10" casing, 64'; 8 $\frac{1}{4}$ ", 1210' (pulled); 6 $\frac{5}{8}$ ", 1432'.  
 Coal was encountered at 90-92'.  
 Oil well. Record to Dept. of Mines stamped Aug. 16, 1949.  
 Record to RCT from Mrs. Griffith Nov. 4, 1949. Old File No. 1410.

	Top.	Bottom.
Coal	90	92
Salt Sand	740	1175
Maxton Sand	1350	1360
Little Lime	1367	1408
Big Lime	1425	1575
Weir Sand (1st oil, 1745'; green oil, 1755')	1735	1829
Total depth		1829





STATE OF WEST VIRGINIA  
DEPARTMENT OF MINES  
OIL AND GAS DIVISION

1416

WELL RECORD

Permit No. 639-A


Oil or Gas Well Oil  
(KIND)

Company Strauss & Beren  
Address Marietta, Ohio  
Farm W. C. Jarrett Acres 40  
Location (waters) Blue Creek  
Well No. 1 Elev. 709.8  
District Elk County Kanawha  
The surface of tract is owned in fee by W. C. Jarrett  
Address Blue Creek, W. Va.  
Mineral rights are owned by \_\_\_\_\_  
Address \_\_\_\_\_  
Drilling commenced May 11, 1916  
Drilling completed June 13, 1916  
Date Shot 6-16-16 From \_\_\_\_\_ To \_\_\_\_\_  
With 150qts.  
Open Flow /10ths Water in \_\_\_\_\_ Inch  
/10ths Merc. in \_\_\_\_\_ Inch  
Volume \_\_\_\_\_ Cu. Ft.  
Rock Pressure \_\_\_\_\_ lbs. \_\_\_\_\_ hrs.  
Oil \_\_\_\_\_ bbls., 1st 24 hrs.  
Fresh water \_\_\_\_\_ feet \_\_\_\_\_ feet  
Salt water \_\_\_\_\_ feet \_\_\_\_\_ feet

Casing and Tubing	Used in Drilling	Left in Well	Packers
Size			Kind of Packer
16			
13			
10	64'	64'	Size of
8 1/4	1210'	None	
6 5/8	1432'	1432'	Depth set
5 3/16			
3			Perf. top
2			Perf. bottom
Liners Used			Perf. top
			Perf. bottom

CASING CEMENTED	SIZE	No. Ft.	Date
COAL WAS ENCOUNTERED AT <u>90</u> FEET INCHES			

Formation	Color	Hard or Soft	Top	Bottom	Oil, Gas or Water	Depth Found	Remarks
Coal			90	92			
Salt Sand			740	1175			
Maxon Sand			1350	1360			
Little Lime			1367	1408			
Big Lime			1425	1575			
Weir Sand			1735	1829	1st. Oil Green Oil	1745 1755	
TOTAL DEPTH				1829			

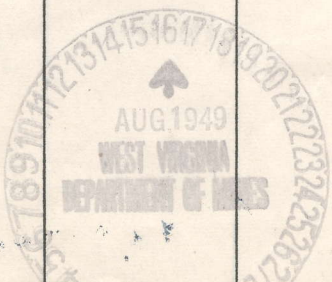

NOV - 4 1949  
(Over)