

New Location..   
 Drill Deeper.....   
 Abandonment.....

Company The Pure Oil Co.  
 Address Newark, Ohio  
 Farm Williams Coal Co.  
 Tract \_\_\_\_\_ Acres 12000 Lease No. 5012  
 Well (Farm) No. 75 Serial No. 313  
 Elevation (Spirit Level) 1455.5  
 Quadrangle Montgomery WC  
 County Kanawha District CabinCreek  
 Engineer J.B. Hunter  
 Engineer's Registration No. Ohio 2912  
 File No. \_\_\_\_\_ Drawing No. \_\_\_\_\_  
 Date 11-22-49 Scale 1" = 200'

STATE OF WEST VIRGINIA  
 DEPARTMENT OF MINES  
 OIL AND GAS DIVISION  
 CHARLESTON

WELL LOCATION MAP  
 FILE NO. KAN-671-A

+ Denotes location of well on United States Topographic Maps, scale 1 to 62,500, latitude and longitude lines being represented by border lines as shown.  
 - Denotes one inch spaces on border line of original tracing.





STATE OF WEST VIRGINIA  
DEPARTMENT OF MINES  
OIL AND GAS DIVISION

1533

WELL RECORD

Permit No. Ab 671-A

Company The Pure Oil Company  
Address PO Box 551- Newark, Ohio  
Farm Williams Coal Company Acres 12,000  
Location (waters) Cabin Creek  
Well No. 75 Elev. 1455.5  
District Cabin Creek County Kanawha - W. Va.  
The surface of tract is owned in fee by Shoak Land Co.  
802 Kanawha Banking & Trust Co. Bldg. Address Charleston, W. Va.  
Mineral rights are owned by Shoak Land Co.  
802 Kanawha Banking & Trust Co. Bldg. Address Charleston, W. Va.  
Drilling commenced 2/13/17  
Drilling completed 6/30/17  
Date Shot 7/20/17 From 314 To 3148  
With 30 qts.  
Open Flow /10ths Water in Inch  
/10ths Merc. in Inch  
Volume  Cu. Ft.  
Rock Pressure  lbs.  hrs.  
Oil  bbls., 1st 24 hrs.  
Fresh water  feet  feet  
Salt water  feet  feet


Water  
Oil or Gas Well Injection  
(KIND)

Casing and Tubing	Used in Drilling	Left in Well	Packers
Size			
16			Kind of Packer
13			
10	875'	875'	Size of
8 1/4	1840'	None	
6 5/8	2195'	2195'	Depth set
5 3/16	2547'	2547'	
3	3131'	3131'	Perf. top
2			Perf. bottom
Liners Used			Perf. top
			Perf. bottom

CASING CEMENTED  SIZE  No. Ft.  Date

COAL WAS ENCOUNTERED AT 700 FEET 36 INCHES  
 FEET  INCHES  FEET  INCHES  
 FEET  INCHES  FEET  INCHES

Formation	Color	Hard or Soft	Top	Bottom	Oil, Gas or Water	Depth Found	Remarks
Clay	yellow		0	6			
Slate	white		6	80			
Sand	white		80	140			
Slate	black		140	150			
Sand	gray		150	220			
Slate	black		220	238			
Sand	white		238	350			
Slate	white		350	375			
Sand	white		375	570			
Slate	black		570	635			
Sand	gray		635	700			
Coal	black		700	703			
Sand	white		703	815			
Slate	black		815	825			
Sand	white		825	865			
Slate	white		865	895			
Lime	white		895	940			
Sand	white		940	975			
Slate	black		975	1075			
Sand	white		1075	1145			
Slate	black		1145	1170			
Sand	white		1170	1340			
Slate	white		1340	1375			
GRAMPUS lime, yellow			1375	1460			
Slate	black		1460	1515			
SALT SAND	black		1515	1840			
Slate	black		1840	1875			
Shells	white		1875	2000			
Rock	red		2000	2040			
Slate	black		2040	2100			
Slate	black		2100	2150			
Lime	black		2150	2175			
Shells	white		2175	2200			
Slate	black		2200	2225			
Rock	red		2225	2335			
MAXON SAND	white		2335	2350			
Slate	black		2350	2385			

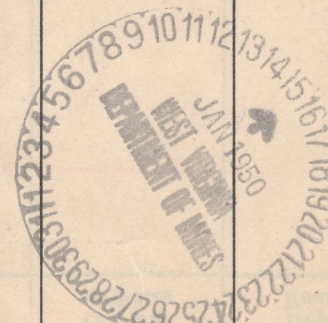

(Over) FEB 23 1951



Formation	Color	Hard or Soft	Top	Bottom	Oil, Gas or Water	Depth Found	Remarks
Little lime	black		2385	2460			
Slate	white		2460	2470			
BIG LIME	white		2470	2710			
INJUN SAND	red		2710	2740			
Slate	gray		2740	3100			
Shale	brown		3100	3122			
BEREA SAND	white		3122	3149			
Lime	black		3149	3154			
		TOTAL DEPTH		3154			

DEVELOPMENT OF MINES Date December 20, 1910

APPROVED By \_\_\_\_\_, Owner

By *Ford Miller* (Title)