

New Location...
 Drill Deeper.....
 Abandonment.....

Company SAM BEREN
 Address 516-4th ST., MARIETTA, OHIO
 Farm REGINA O'DELL
 Tract _____ Acres _____ Lease No. _____
 Well (Farm) No. -2- Serial No. 1729
 Elevation (Spirit Level) 879'
 Quadrangle CLENDENIN SC
 County KANAWHA District CABIN CREEK
 Engineer B. P. Melz
 Engineer's Registration No. 9
 File No. _____ Drawing No. _____
 Date 10-6-49 Scale 1"-400'

STATE OF WEST VIRGINIA
 DEPARTMENT OF MINES
 OIL AND GAS DIVISION
 CHARLESTON

WELL LOCATION MAP
 FILE NO. KAN-682-A

+ Denotes location of well on United States Topographic Maps, scale 1 to 62,500, latitude and longitude lines being represented by border lines as shown.

- Denotes one inch spaces on border line of original tracing.

REGINA O'DELL NO. 2 (1729) WELL.

682A

Cabin Creek District, Kanawha County, W. Va.
 By W. L. Thaxton, Box 147, Sissonville, W. Va.
 Abandoned under permit Kan-.....-A?
 On.....acres, on Kelly Creek.
 Elevation, 879' L.
 Date of completion, etc., not given.
 6⁵/₈" casing, 1542'; 2" tubing, 1950'; all left in.
 Oil well. Record to Dept. of Mines stamped Jan. 25, 1950.
 Record to RCT from Mrs. Griffith March 6, 1950. Old File No. 1433.
 The formations given below are from a near-by well. No record available
 for this well.

	Top.	Bottom.
Gravel	0	30
Lime	30	50
Coal	50	55
Slate	55	180
Coal	180	185
Slate	185	270
Sand	270	315
Slate	315	365
Sand	365	425
Slate	425	435
Sand	435	495
Slate	495	530
Sand	530	555
Slate	555	558
Sand	558	625
Slate	625	630
Sand	630	700
Slate	700	790
Lime	790	810
Sand	810	915
Slate	915	920
Sand	920	935
Slate	935	980
Sand	980	1000
Sand	1000	1080
Shells	1080	1145
Red rock	1145	1175
Slate rock	1175	1210
Sand	1210	1275
Red rock	1275	1315
Sand	1315	1375
Shells	1375	1430
Lime shells	1430	1460
Slate	1460	1480
Lime	1480	1486
Slate, Pencil	1486	1512
Big Lime	1512	1690
Big Injun Sand	1690	1725
Slate	1725	1748
Weir Sand	1748	1944
Lime	1944	1945
Total depth		1945



1433

STATE OF WEST VIRGINIA
DEPARTMENT OF MINES
OIL AND GAS DIVISION

WELL RECORD

Permit No. KAN-682-A

Oil or Gas Well X (KIND)

Company W. L. Thaxton
 Address Box 147 - Sissonville, W. Va.
 Farm Regina O'Dell Acres _____
 Location (waters) Kelleys Creek
 Well No. 2 - Sr-1729 Elev. 879'
 District Cabin Creek County Kanawha
 The surface of tract is owned in fee by _____
 Address _____
 Mineral rights are owned by _____
 Address _____
 Drilling commenced _____
 Drilling completed not given
 Date Shot _____ From _____ To _____
 With _____
 Open Flow _____ /10ths Water in _____ Inch
 _____ /10ths Merc. in _____ Inch
 Volume _____ Cu. Ft.
 Rock Pressure _____ lbs. _____ hrs.
 Oil _____ bbls., 1st 24 hrs.
 Fresh water _____ feet _____ feet
 Salt water _____ feet _____ feet

Casing and Tubing	Used in Drilling	Left in Well	Packers
Size			Kind of Packer
16			
13			
10			Size of
8 1/2			
6 5/8	1542	1542	Depth set
5 3/16			
3			Perf. top
2	1950	1950	Perf. bottom
Liners Used			Perf. top
			Perf. bottom


CASING CEMENTED _____ SIZE _____ No. Ft. _____ Date _____

COAL WAS ENCOUNTERED AT _____ FEET _____ INCHES

_____ FEET _____ INCHES _____ FEET _____ INCHES

_____ FEET _____ INCHES _____ FEET _____ INCHES

Formation	Color	Hard or Soft	Top	Bottom	Oil, Gas or Water	Depth Found	Remarks
The formations given below are from a nearby well no record available for this well							
Gravel				30			
Lime			30	50			
Coal			50	55			
Slate			55	100			
Coal			100	185			
Slate			185	270			
Sand			270	315			
Slate			315	365			
Sand			365	425			
Slate			425	435			
Sand			435	495			
Slate			495	530			
Sand			530	555			
Slate			555	558			
Sand			558	625			
Slate			625	630			
Sand			630	700			
Slate			700	790			
Lime			790	810			
Sand			810	915			
Slate			915	920			
Sand			920	935			
Slate			935	980			
Sand			980	1000			
Sand			1000	1080			
Shells			1080	1145			
Red Rock			1145	1175			
Slate Rock			1175	1210			
Sand			1210	1275			
Red Rock			1275	1315			
Sand			1315	1375			
Shells			1375	1430			
Lime Shells			1430	1460			
Slate			1460	1480			
Lime			1480	1486			
Slate p Pencil			1486	1512			

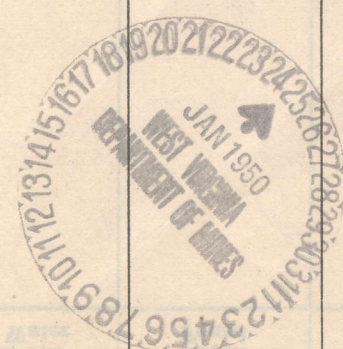

(Over)

MAR 6 1950

Formation	Color	Hard or Soft	Top	Bottom	Oil, Gas or Water	Depth Found	Remarks
2g Line			1512	1690			
Big Injun			1690	1725			
Slate			1725	1748			
Weir Sand			1748	1944			
Line			1944	1945			
Total Depth				1945			

DEPARTMENT OF MINES
STATE OF ARIZONA

Date _____, 19____

APPROVED _____, Owner

By _____

(Title)