

Surface owned by Robert Jarrett.
 Address: Mr. Robert Jarrett, Pinch, Kanawha Co. W. Va.
 No commercial coal, if any coal, it belongs to the owner of the surface.

New Location...
 Drill Deeper...
 Abandonment... On 800' Map No. 100. Sqs. S 70 W 49-50.

Company Road Supply Co.
 Address Salem, W. Va.
 Farm W. S. Jarrett
 Tract _____ Acres 70 3/10 Lease No. _____
 Well (Farm) No. 9. Serial No. _____
 Elevation (Spirit Level) Floor -- 690.62
Ground - 689.27
 Quadrangle Clendenin
 County Kanawha District Elk
 Engineer Elsworth Haines
 Engineer's Registration No. 2221.
 File No. _____ Drawing No. _____
 Date July 11th, 1950. Scale 1" = 400 Feet

STATE OF WEST VIRGINIA
 DEPARTMENT OF MINES
 OIL AND GAS DIVISION
 CHARLESTON

WELL LOCATION MAP
 FILE NO. KAN-743-A

+ Denotes location of well on United States Topographic Maps, scale 1 to 62,500, latitude and longitude lines being represented by border lines as shown.

- Denotes one inch spaces on border line of original tracing.

6-0 217



STATE OF WEST VIRGINIA
DEPARTMENT OF MINES
OIL AND GAS DIVISION

1467

Permit No. KAN-743-A

WELL RECORD

Oil or Gas Well

(KIND)

Company Reed Supply Company
Address 184 East Main St., Salem, W. Va.
Farm W. S. Jarrett Acres 70 3/10
Location (waters) Rt. Plk. of Pinch Creek
Well No. 9 Elev. 689.27
District Elk County Kanawha
The surface of tract is owned in fee by Robert Jarrett
Address Pinch, W. Va.
Mineral rights are owned by No Coal
Address _____


Casing and Tubing	Used in Drilling	Left in Well	Packers
Size			
16			Kind of Packer
13			
10			Size of
8 1/4	465'	465'	
6 5/8	1481'	1481'	Depth set
5 3/16	1616'	1616'	
3			Perf. top
2	1734'	1734'	Perf. bottom
Liners Used			Perf. top
			Perf. bottom

Drilling commenced NO RECORD
Drilling completed _____
Date Shot _____ From _____ To _____
With _____
Open Flow _____ /10ths Water in _____ Inch
_____ /10ths Merc. in _____ Inch
Volume _____ Cu. Ft.
Rock Pressure _____ lbs. _____ hrs.
Oil _____ bbls., 1st 24 hrs.
Fresh water _____ feet
Salt water _____ feet

CASING CEMENTED No SIZE _____ No. Ft. _____ Date _____

COAL WAS ENCOUNTERED AT 314 FEET 48 INCHES
_____ FEET _____ INCHES _____ FEET _____ INCHES
_____ FEET _____ INCHES _____ FEET _____ INCHES

Formation	Color	Hard or Soft	Top	Bottom	Oil, Gas or Water	Depth Found	Remarks
Coal Seam			310	314			
Salt sand			770	1270	Water -	895'	
Maxon Sand			1345	1420			
Big Lime			1457	1622			
Big Injun			1622	1629			
Squaw Sand			1713	1731	Oil and Gas -	1716'	
Total Depth				1734			

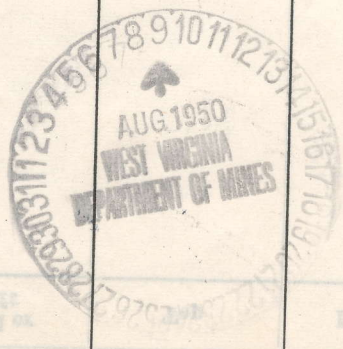

SEP - 9 1950

