

772-A	S	2.57
#17	W	2.52
773-A	S	2.33
#32	W	2.48

New Location
 Drill Deeper
 Abandonment

Company KREBS OIL CO., INC.
 Address CHAS. NAT. BANK BLDG.,
 Farm C. J. HUNT CHAS. W. VA
 Tract _____ Acres 929 Lease No. 27480
 Well (Farm) No. 17-32 Serial No. 3459
3212
 Elevation (Spirit Level) AS ABOVE
 Quadrangle CLENDENIN
 County KANAWHA District ELK WC
 Engineer L. S. Krebs
 Engineer's Registration No. 773
 File No. _____ Drawing No. _____
 Date 9-13-50 Scale 1"-1320'

STATE OF WEST VIRGINIA
 DEPARTMENT OF MINES
 OIL AND GAS DIVISION
 CHARLESTON

WELL LOCATION MAP
 FILE NO. KAN-772-A-#17
KAN-773-A-#32

+ Denotes location of well on United States Topographic Maps, scale 1 to 62,500, latitude and longitude lines being represented by border lines as shown.
 - Denotes one inch spaces on border line of original tracing.



STATE OF WEST VIRGINIA
DEPARTMENT OF MINES
OIL AND GAS DIVISION

1490

Permit No. Kan-773-82

WELL RECORD


Oil or Gas Well X
(KIND)

Company Krebs Oil Company
 Address Box 213 - Charleston, W.Va.
 Farm C. J. HUNT Acres 946
 Location (waters) Indian Creek
 Well No. 32 Elev. 1044'
 District Elk County Kanawha
 The surface of tract is owned in fee by _____
 Address _____
 Mineral rights are owned by Preston Oil Company
Charleston, W.Va. Address _____
 Drilling commenced July 8th, 1920
 Drilling completed Sept. 21st, 1920
 Date Shot 9/22/20 From _____ To _____
 With _____
 Open Flow _____ /10ths Water in _____ Inch
 _____ /10ths Merc. in _____ Inch
 Volume _____ Cu. Ft.
 Rock Pressure _____ lbs. _____ hrs.
 Oil _____ bbls., 1st 24 hrs.
 Fresh water _____ feet _____ feet
 Salt water _____ feet _____ feet

Casing and Tubing	Used in Drilling	Left in Well	Packers
Size			Kind of Packer
16			
13			
10			Size of
8 1/2	430'	430'	
6 5/8	1610'	1610'	Depth set
5 3/16			
3			Perf. top
2			Perf. bottom
Liners Used			Perf. top
			Perf. bottom

CASING CEMENTED _____ SIZE _____ No. Ft. _____ Date _____
 COAL WAS ENCOUNTERED AT _____ FEET _____ INCHES
 _____ FEET _____ INCHES FEET _____ INCHES
 _____ FEET _____ INCHES FEET _____ INCHES

Formation	Color	Hard or Soft	Top	Bottom	Oil, Gas or Water	Depth Found	Remarks
Slate and Shells				900			
Salt Sand			900	1400			
Slate			1400	1440			
Maxton sand			1440	1550			
Little Lime			1550	1585			
Break			1585	1590			
Lime shells			1590	1600			
Break			1600	1608			
Big Lime			1608	1773			
Injun Sand			1773	1808			
Slate and Shells			1808	1900			
Weir Sand			1900	1960			
TOTAL DEPTH	- - - - -	- - - - -	- - - - -	1962'			
Green Oil at		1927'	1935'				
Gas at			1935'				

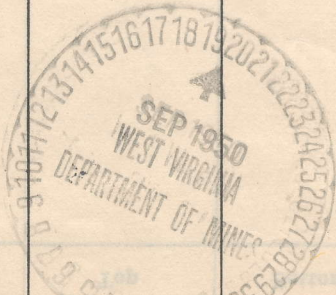

NOV 18 1950