

New Location   
 Drill Deeper   
 Abandonment

Company SAM BEREN  
 Address 516-4th St., MARIETTA, OHIO  
 Farm G.W. BELCHER  
 Tract \_\_\_\_\_ Acres 183 Lease No. 738  
 Well (Farm) No. 2-4-15 Serial No. (3140)  
 Elevation (Spirit Level) SEE ABOVE (3142)  
 Quadrangle CLENDENIN (3333)  
 County KANAWHA District ELK NW  
 Engineer L. P. Kuehl  
 Engineer's Registration No. 9  
 File No. \_\_\_\_\_ Drawing No. \_\_\_\_\_  
 Date 9-12-49 Scale 1"=1320'

STATE OF WEST VIRGINIA  
 DEPARTMENT OF MINES  
 OIL AND GAS DIVISION  
 CHARLESTON

WELL LOCATION MAP  
 FILE NO. KAN-782-A-#2  
KAN-783-A-#4  
KAN-784-A-#15

+ Denotes location of well on United States Topographic Maps, scale 1 to 62,500, latitude and longitude lines being represented by border lines as shown.  
 - Denotes one inch spaces on border line of original tracing.





STATE OF WEST VIRGINIA  
DEPARTMENT OF MINES  
OIL AND GAS DIVISION

1509

WELL RECORD

Permit No. 784-A Oil or Gas Well X (KIND)


Company Valley Steel Products Company  
Address Saint Louis, Mo.  
Farm G. W. Belcher Acres 183  
Location (waters) Blue Creek  
Well No. 15 (3333) Elev. 796'  
District Elk County Kanawha  
The surface of tract is owned in fee by G.W. Belcher Hrs.  
Address Blue Creek, W.Va.  
Mineral rights are owned by Coal Not Operated  
Address \_\_\_\_\_  
Drilling commenced Aug. 9, 1917  
Drilling completed Sept. 27, 1917  
Date Shot 10-4-17 From \_\_\_\_\_ To \_\_\_\_\_  
With \_\_\_\_\_

Casing and Tubing	Used in Drilling	Left in Well	Packers
Size			Kind of Packer
16			
18			Size of
10			Depth set
8 1/4	415'	None	Perf. top
6 5/8	1470'	1470'	Perf. bottom
5 3/16	73 1/2	58	Perf. top
3			Perf. bottom
2			
Liners Used			

Open Flow \_\_\_\_\_ /10ths Water in \_\_\_\_\_ Inch  
\_\_\_\_\_ /10ths Merc. in \_\_\_\_\_ Inch  
Volume \_\_\_\_\_ Cu. Ft.  
Rock Pressure \_\_\_\_\_ lbs. \_\_\_\_\_ hrs.  
Oil \_\_\_\_\_ bbls., 1st 24 hrs.  
Fresh water \_\_\_\_\_ feet \_\_\_\_\_ feet  
Salt water \_\_\_\_\_ feet \_\_\_\_\_ feet

CASING CEMENTED \_\_\_\_\_ SIZE \_\_\_\_\_ No. Ft. \_\_\_\_\_ Date \_\_\_\_\_  
COAL WAS ENCOUNTERED AT 580 FEET \_\_\_\_\_ INCHES  
\_\_\_\_\_ FEET \_\_\_\_\_ INCHES FEET \_\_\_\_\_ INCHES  
\_\_\_\_\_ FEET \_\_\_\_\_ INCHES FEET \_\_\_\_\_ INCHES

Formation	Color	Hard or Soft	Top	Bottom	Oil, Gas or Water	Depth Found	Remarks
Coal			580	584			
Salt Sand			750'	1240			
Maxon Sand			1370	1385			
Little Lime			1405	1442			
Pencil Cave			1456	1463			
Big Lime			1469	1624			
Weir Sand			1710	1865			
Total Depth				1873			

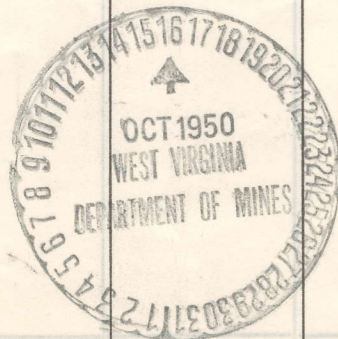

(Over) FEB 23 1951