



New Location
 Drill Deeper
 Abandonment

Company KREBS OIL CO., INC.
 Address CHAS. NAT. BANK BLDG.
 Farm EDWARD GEBHART
 Tract _____ Acres 900 Lease No. 881
 Well (Farm) No. 3-4 Serial No. 3118
 Elevation (Spirit Level) AS ABOVE
 Quadrangle CLENDENIN
 County KANAWHA District FLK
 Engineer E. J. Krebs
 Engineer's Registration No. 773
 File No. _____ Drawing No. _____
 Date 11-7-50 Scale 1" - 1320'

STATE OF WEST VIRGINIA
 DEPARTMENT OF MINES
 OIL AND GAS DIVISION
 CHARLESTON

WELL LOCATION MAP
 FILE NO. _____

+ Denotes location of well on United States Topographic Maps, scale 1 to 62,500, latitude and longitude lines being represented by border lines as shown.

- Denotes one inch spaces on border line of original tracing.

794A

Elk District, Kanawha County, W. Va.
 By Krebs Oil Co., Charleston, W. Va.
 Abandoned under permit Kan-.....-A?
 On 900 acres, on Blue Creek.
 Elevation,¹ L.

Minerals owned by Kanawha Crude Oil Co., Charleston, W. Va.
 Drilling commenced Oct. 23, 1914; completed Dec. 19, 1914.

8 1/2" casing, 565' (265' left in); 6" casing, 1445'; 5" casing, 1783'; 2" tubing, 1848'.
 Hole full water, 551'. Water, 820'. Hole full water, 850'.
 Little gas, 169 1/2'. More gas, 1719'. Little gas and oil, 1808'; flowing,
 1830'.

Oil well. Record to Dept. of Mines stamped Nov. 10, 1950.

Record to RGT from Mrs. Griffith June 24, 1951. Old File No. 1542.

	Top.	Bottom.
Clay	0	15
Sand	16	90
Coal	90	94
Slate	94	100
Sand	100	250
Slate and shells	250	551
Coal	551	555
Line	555	585
Slate and shells	585	720
Salt Sand	720	1255
Line	1255	1265
Red rock	1265	1290
Slate	1290	1298
Line	1298	1322
Red rock	1322	1346
Slate	1346	1354
Nexton Sand	1354	1376
Slate	1376	1380
Little Line	1380	1413
Slate	1413	1415
Line	1415	1419
Slate	1419	1423
Line	1423	1431
Pencil Cave	1431	1438
Big Line	1438	1597
Slate	1597	1605
Red rock	1605	1625
Slate and shells	1625	1664
Weir Sand	1664	1846
Total depth		1848



STATE OF WEST VIRGINIA
DEPARTMENT OF MINES
OIL AND GAS DIVISION

1542

WELL RECORD

Permit No. 794-A

Oil or Gas Well (KIND)

Company Krebs Oil Company
Address Charleston, W. Va.
Farm Edward Gebhart Acres 900
Location (waters) Blue Creek
Well No. 3 Elev. _____
District Elk County Kanawha
The surface of tract is owned in fee by _____
Address _____
Mineral rights are owned by Kanawha Crude Oil Co.
Charleston, W. Va. Address _____

Drilling commenced October 23, 1914
Drilling completed December 19, 1914
Date Shot _____ From _____ To _____
With _____

Open Flow _____ /10ths Water in _____ Inch
_____ /10ths Merc. in _____ Inch
Volume _____ Cu. Ft.
Rock Pressure _____ lbs. _____ hrs.
Oil _____ bbls., 1st 24 hrs.
Fresh water _____ feet _____ feet
Salt water _____ feet _____ feet


Casing and Tubing	Used in Drilling	Left in Well	Packers
Size			
16			Kind of Packer _____
13			
10			Size of _____
8 1/4	565'	265'	
6 5/8	1445'	1445'	Depth set _____
5 3/16	1783'	1783'	
3			Perf. top _____
2	1848'	1848'	Perf. bottom _____
Liners Used			Perf. top _____
			Perf. bottom _____

CASING CEMENTED _____ SIZE _____ No. Ft. _____ Date _____

COAL WAS ENCOUNTERED AT _____ FEET _____ INCHES
_____ FEET _____ INCHES _____ FEET _____ INCHES
_____ FEET _____ INCHES _____ FEET _____ INCHES

Formation	Color	Hard or Soft	Top	Bottom	Oil, Gas or Water	Depth Found	Remarks
Clay				15	Hole full water	551'	
Sand			16	90	Water	820'	
Coal			90	94	Hole full water	850'	
Slate			94	100	Little Gas	1694'	
Sand			100	250	More Gas	1719'	
Slate and Shells			250	551	Little Gas & Oil	1808'	
Coal			551	555	Flowing	1830'	
Lime			555	585			
Slate and Shells			585	720			
Salt Sand			720	1255			
Lime			1255	1265			
Red Rock			1265	1290			
Slate			1290	1298			
Lime			1298	1322			
Red Rock			1322	1346			
Slate			1346	1354			
Maxon Sand			1354	1376			
Slate			1376	1380			
Little Lime			1380	1413			
Slate			1413	1415			
Lime			1415	1419			
Slate			1419	1423			
Lime			1423	1431			
Pencil Cave			1431	1438			
Big Lime			1438	1597			
Slate			1597	1605			
Red Rock			1605	1625			
Slate and Shale			1625	1664			
Weir Sand			1664	1846			
Total Depth				1848'			

1542

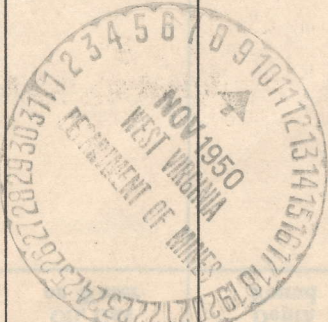

JUN 24 1951