

New Location...
 Drill Deeper.....
 Abandonment.....

Company SAM BEREN
 Address 516-4th St, MARIETTA, OHIO
 Farm JENNIE HOOVER
 Tract _____ Acres 90 Lease No. 740
 Well (Farm) No. 2-3 Serial No. 3178
 Elevation (Spirit Level) 1017' 882'
 Quadrangle CLENDENIN
 County KANAWHA District ELK
 Engineer B. E. Belcher
 Engineer's Registration No. 9
 File No. _____ Drawing No. _____
 Date 9-29-49 Scale 1" - 400'

STATE OF WEST VIRGINIA
 DEPARTMENT OF MINES
 OIL AND GAS DIVISION
 CHARLESTON

WELL LOCATION MAP
 FILE NO. _____

+ Denotes location of well on United States Topographic Maps, scale 1 to 62,500, latitude and longitude lines being represented by border lines as shown.

- Denotes one inch spaces on border line of original tracing.



STATE OF WEST VIRGINIA
DEPARTMENT OF MINES
OIL AND GAS DIVISION

1602

WELL RECORD

Permit No. 796-A


Oil or Gas Well X
(KIND)

Company Valley Steel Products Co.
 Address Saint Louis, Mo.
 Farm Jennie Hoover Acres 90
 Location (waters) Blue Creek
 Well No. 2 Elev. 1017'
 District Elk County Kanawha
 The surface of tract is owned in fee by Jennie Hoover
 Address Blue Cr., W. Va.
 Mineral rights are owned by Coal Not Operated
 Address _____
 Drilling commenced March 20, 1915
 Drilling completed May 10, 1915
 Date Shot 5-31-15 From _____ To _____
 With 100 qts.
 Open Flow _____ /10ths Water in _____ Inch
 _____ /10ths Merc. in _____ Inch
 Volume _____ Cu. Ft.
 Rock Pressure _____ lbs. _____ hrs.
 Oil _____ bbls., 1st 24 hrs.
 Fresh water _____ feet _____ feet
 Salt water _____ feet _____ feet

Casing and Tubing	Used in Drilling	Left in Well	Packers
Size			Kind of Packer
16			
13			
10			Size of
8 1/4	640'	None	
6 5/8	1668'	1668'	Depth set
5 3/16			
3			Perf. top
2			Perf. bottom
Liners Used			Perf. top
			Perf. bottom

CASING CEMENTED _____ SIZE _____ No. Ft. _____ Date _____
 COAL WAS ENCOUNTERED AT _____ FEET _____ INCHES
 _____ FEET _____ INCHES FEET _____ INCHES
 _____ FEET _____ INCHES FEET _____ INCHES

Formation	Color	Hard or Soft	Top	Bottom	Oil, Gas or Water	Depth Found	Remarks
Salt Sand			985	1458			
Maxon Sand			1580	1598			
Little Lime			1603	1633			
Big Lime			1665	1830			
Weir Sand			1974	2082			
TOTAL DEPTH				2084			

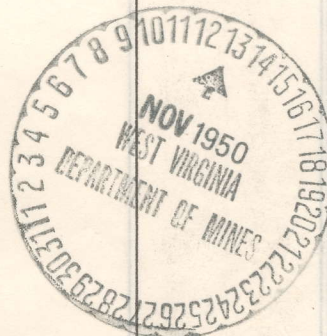

(Over)

NOV 28 1951