

New Location L. SEABOLT
 Drill Deeper
 Abandonment 100 5/8 ac

Company KOONTZ & OSBORNE
 Address CLENDENIN, W. VA.
 Farm BIRD HRS. (MAYFIELD)
 Tract _____ Acres 7 Lease No. _____
 Well (Farm) No. 1 Serial No. F-4430
 Elevation (Spirit Level) 756
 Quadrangle WALTON
 County KANAWHA District BIG SANDY
 Engineer PAUL E. JOACHIM
 Engineer's Registration No. 669
 File No. 74-69 Drawing No. _____
 Date MARCH 11, 1951 Scale 1" = 200'

STATE OF WEST VIRGINIA
 DEPARTMENT OF MINES
 OIL AND GAS DIVISION
 CHARLESTON

WELL LOCATION MAP
 FILE NO. KAN-830-A

+ Denotes location of well on United States Topographic Maps, scale 1 to 62,500, latitude and longitude lines being represented by border lines as shown.

- Denotes one inch spaces on border line of original tracing.

Handwritten: 2.78 W
4.73 E

Handwritten: 6-0 220

Handwritten: KOONTZ & OSBORNE
 (see also records)

Handwritten: BIRD HRS (MAYFIELD) CO., (F-4430) - KAN-830-A

BIRD HEIRS NO. 1 (MAYFIELD) WELL.

2302

Big Sandy District, Kanawha County, W. Va.
 By Valley Steel Products Co., St. Louis, Mo. (Formerly Koontz & Osborne well).
 Abandoned under permit Kan-.....-A1
 On 7 acres, on Buffalolick, 2 mi. from mouth.
 Drilling completed, approx. Aug. 12, 1919.
 8 1/2" casing, 354'; 6 3/8", 1577'; 2" tubing, 1746'.
 Packer set at 1595'.
 Perf. top, 1692'; bottom, 1712'.
 Gas well. Record to Dept. of Mines stamped March 21, 1951.
 Record to RCT from Mrs. Griffith Aug. 17, 1951. Old File No. 1562.

	Top.	Bottom.
Sand	3	380
Slate	380	500
Sand	500	715
Black slate	715	750
Sand	750	780
Black slate	780	865
Sand	865	885
Sandy lime	885	905
Slate	905	935
Slate	935	985
Salt Sand (gas, 1015'; first water, 1020')	985	1385
Slate	1385	1430
Marston Sand	1430	1510
Little Lime	1510	1540
Pencil Cave	1540	1545
Big Lime (gas, 1642')	1545	1666
Big Injun Sand (gas, 1684'; gas, 1694'; gas, 1714-1718')	1666	1718
Slate and shell	1718	2033
Total depth (when drilled)		2033
Filled with rock and sediment to		1733



1062

STATE OF WEST VIRGINIA
DEPARTMENT OF MINES
OIL AND GAS DIVISION

Formerly Koontz & Osborne

WELL RECORD

Permit No. KAN-830-A

Oil or Gas Well _____
(KIND)


Company Valley Steel Products Company
 Address St. Louis, Mo.
 Farm Bird Heirs Acres 7
 Location (waters) Buffalo Dick-2 Mi. from mouth
 Well No. 1 (Mayfield) Elev. 756'
 District Big Sandy County Kanawha
 The surface of tract is owned in fee by _____
 Address _____
 Mineral rights are owned by _____
 Address _____
 Drilling commenced _____
 Drilling completed Approx 8/12/1919
 Date Shot From _____ To _____
 With _____
 Open Flow /10ths Water in _____ Inch
 /10ths Merc. in _____ Inch
 Volume _____ Cu. Ft.
 Rock Pressure _____ lbs. _____ hrs.
 Oil _____ bbls., 1st 24 hrs.
 Fresh water _____ feet _____ feet
 Salt water _____ feet _____ feet

Casing and Tubing	Used in Drilling	Left in Well	Packers
Size			Kind of Packer
16			
13			
10			Size of
8 1/4		354'	
6 5/8		1577'	Depth set 1595'
5 3/16			
3			Perf. top 1692'
2		1746'	Perf. bottom 1712'
Liners Used			Perf. top _____
			Perf. bottom _____

CASING CEMENTED _____ SIZE _____ No. Ft. _____ Date _____
 COAL WAS ENCOUNTERED AT _____ FEET _____ INCHES
 _____ FEET _____ INCHES FEET _____ INCHES
 _____ FEET _____ INCHES FEET _____ INCHES

Formation	Color	Hard or Soft	Top	Bottom	Oil, Gas or Water	Depth Found	Remarks
Sand			3	380			
Slate			380	500			
Sand			500	715			
Black Slate			715	750			
Sand Sand			750	730			
Black Slate			780	865			
Sand			865	885			
Sandy Lime			885	905			
Slate			905	935			
Slate			935	935			
Salt Sand			935	1385			
Gas in Salt Sand			1015				
First Water			1020				
Slate			1385	1430			
Maxon Sand			1430	1510			
Little Lime			1510	1540			
Pencil Cave			1540	1545			
Big Lime			1545	1666			
Gas			1642				
Big Injun			1666	1718			
Gas			1684				
Gas			1694				
Gas			1714	1718			
Slate & shell			1718	2033'			
Total Depth - when drilled				2033'			

Hole filled up from depth of 2033' to a depth of 1733' with rock & sediment

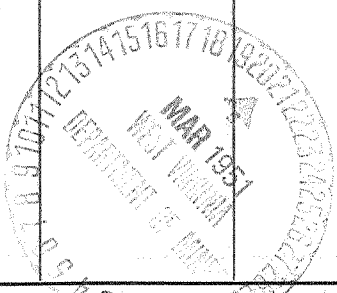

(Over)

AUG 17 1951