

Company PACK & JACKSON
 Address HAMLIN, W. VA.
 Farm WM. S. JARRETT
 Tract _____ Acres 71 Lease No. _____
 Well (Farm) No. 8 Serial No. F-1638
 Elevation (Spirit Level) 798
 Quadrangle CLENDENIN
 County KANAWHA District ELK
 Engineer PAUL E. JOACHIM
 Engineer's Registration No. 669
 File No. 70-63 Drawing No. _____
 Date JUNE 24, 1951 Scale 1" = 400'

STATE OF WEST VIRGINIA
 DEPARTMENT OF MINES
 OIL AND GAS DIVISION
 CHARLESTON

WELL LOCATION MAP
 FILE NO. KAN-872-A

+ Denotes location of well on United States Topographic Maps, scale 1 to 62,500, latitude and longitude lines being represented by border lines as shown.

- Denotes one inch spaces on border line of original tracing.

WM. S. JARRETT NO. 8 WELL.

Elk District, Kanawha County, W. Va.
By Pack & Jackson, Hal Pack, Hamlin, W. Va.
Abandoned under permit Ken-.....-A?

On 71 acres,

Elevation, 798' L.

Date of completion, etc., not given.

Shot Nov. 21, 1912, with 30 qts., at 1829'; Feb. 22, 1915, with 80 qts.,
at 1830'; and May 5, 1915, with 60 qts., at 1851'. Bridged near
bottom of Squaw Sand.

Formerly a South Penn Natural Gas Co. well.

8" casing, 485'; 7" O. D., 1595'; 5 1/2", 1635'; 2" tubing, 1880'.

Oil well. Record to Dept. of Mines stamped July 9, 1951.

Record to RCT from Mrs. Griffith Nov. 28, 1951. Old File No. 1606.

	Top.	Bottom.
Coal	275	- 279
Coal	425	- 429
Salt Sand	870	- 1428
Maxton Sand	1480	- 1528
Big Lime	1589	- 1751
Squaw Sand (oil and gas, 1830')	1827	- 1851
Weir Sand (oil, 1952-1957')	1950	- 2002
Total depth		2002



STATE OF WEST VIRGINIA
DEPARTMENT OF MINES
OIL AND GAS DIVISION

1606

WELL RECORD

Formerly - South Penn Nat'l
Gas Company
Oil or Gas Well (KIND)

Permit No. KAN-872-A


Company Pack & Jackson
Address c/o Hal Pack - Maulin, W. Va.
Farm Wm. S. Jarrett Acres 71
Location (waters) _____
Well No. 8 Elev. 700.0
District 81k County Kanawha
The surface of tract is owned in fee by _____
Address _____
Mineral rights are owned by _____
Address _____
Drilling commenced _____
Drilling completed _____
Date Shot _____ From _____ To _____
With _____
Open Flow _____ /10ths Water in _____ Inch
_____ /10ths Merc. in _____ Inch
Volume _____ Cu. Ft.
Rock Pressure _____ lbs. _____ hrs.
Oil _____ bbls., 1st 24 hrs.
Fresh water _____ feet _____ feet
Salt water _____ feet _____ feet

Casing and Tubing	Used in Drilling	Left in Well	Packers
Size			Kind of Packer
16			
18			
10			Size of
3 1/2 - 5/8"	485	485	
6 1/2 - 7" OD	1505	1505	Depth set
5 3/16 - 8"	1635	1635	
3			Perf. top
2	1850	1850	Perf. bottom
Liners Used			Perf. top
			Perf. bottom

CASING CEMENTED _____ SIZE _____ No. Ft. _____ Date _____

COAL WAS ENCOUNTERED AT _____ FEET _____ INCHES
_____ FEET _____ INCHES FEET _____ INCHES
_____ FEET _____ INCHES FEET _____ INCHES

Formation	Color	Hard or Soft	Top	Bottom	Oil, Gas or Water	Depth Found	Remarks
Coal			275	270			
Coal			425	420			
Salt Sand			670	1488			
Maxon Sand			1480	1583			
Big Lime			1580	1751			
Squaw Sand			1827	1851			
Oil and Gas			1850				
Weir Sand			1950	2002			
Oil			1952	1957			
Total Depth				2002			
<u>Shot Record</u>							
11/21/12	30 lbs.		1800				
2/22/15	30 "		1830				
5/5/15	60		1851				
Bridged near bottom of Squaw Sand							

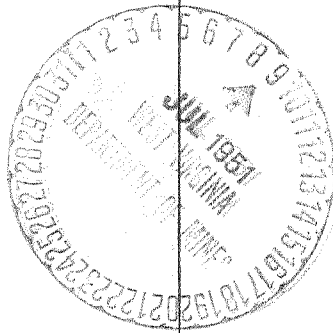

NOV 20 1951