

Company SEATEX OIL CO., INC.
 Address FALLING ROCK, W. VA.
 Farm FALLING ROCK PRODUCING CO.
 Tract _____ Acres 3240 Lease No. WEIR FEE
 Well (Farm) No. 36-80-82 Serial No. AS ABOVE
 Elevation (Spirit Level) AS ABOVE
 Quadrangle CLENDENIN
 County KANAWHA District BIG SANDY
 Engineer [Signature]
 Engineer's Registration No. 773
 File No. _____ Drawing No. _____
 Date 7-20-51 Scale 1" = 660'

STATE OF WEST VIRGINIA
 DEPARTMENT OF MINES
 OIL AND GAS DIVISION
 CHARLESTON

WELL LOCATION MAP
 FILE NO. SEE ABOVE

Blue CK 7.5

+ Denotes location of well on United States Topographic Maps, scale 1 to 62,500, latitude and longitude lines being represented by border lines as shown.

- Denotes one inch spaces on border line of original tracing.

FALLING ROCK PRODUCING Co. Nos. 21, 24, 29, 36, 80, & 82 - SEATEX OIL Co., INC. - KAN-890-1-2-3-89A-5A

FALLING ROCK PRODUCING CO. NO. 21 WELL.

290A

Big Sandy District, Kanawha County, W. Va.

By Seatex Oil Co., Inc., Falling Rock, W. Va.

Abandoned under permit Kan-.....-A?

On 3240 acres, on Falling Rock Creek.

Elevation, 1056' L.

Drilling completed Aug. 5, 1912.

Hole full of water at 910'.

Gas, 1,000,000 cu. ft. at 162'?

Oil, 1697 to 1715' - also big gas. Gas about 10,000,000 cu. ft.;
oil about 75 bbls. per day.

13" conductor, 14'; 10" casing, 18' (pulled); 8½", 410' (pulled);
6¾", 1318'.

Oil and gas well. Record to Dept. of Mines stamped Aug. 8, 1951.

Record to RCT from Mrs. Griffith Aug. 27, 1951. Old File No. 1579.

	Top.	Bottom.
Various formations	0	578
Cow Run Sand	578	810
Slate	810	825
Salt Sand	825	1100
Red rock	1100	1104
Black slate	1104	1130
Shells and slate	1130	1180
Sand	1180	1188
Lime	1188	1197
Red rock	1197	1201
Slate	1201	1210
Naxton Sand	1210	1235
Slate	1235	1245
Little Lime	1245	1275
Pencil Cave	1275	1292
Lime	1292	1309
Break (black)	1309	1312
Big Lime	1312	1462
Slate	1462	1495
Weir Sand	1495	1715
Total depth		1715



1579

STATE OF WEST VIRGINIA
DEPARTMENT OF MINES
OIL AND GAS DIVISION

WELL RECORD

Permit No. KAN-890-A

Oil or Gas Well _____
(KIND)


Company Seatex Oil Company, Inc.
 Address Falling Rock, W. Va.
 Farm Falling Rock Producing Co. 3240
 Location (waters) Falling Rock Creek
 Well No. 21 Elev. 1056.1
 District Big Sandy County Kanawha
 The surface of tract is owned in fee by _____
 Address _____
 Mineral rights are owned by _____
 Address _____
 Drilling commenced _____
 Drilling completed August 5, 1912
 Date Shot _____ From _____ To _____
 With _____

Casing and Tubing	Used in Drilling	Left in Well	Packers
Size			
16			Kind of Packer
13 Conductor	14'		
10	19'		Size of
8 1/4	410'		
6 5/8	1318	1318	Depth set
5 3/16			
3			Perf. top
2			Perf. bottom
Liners Used			Perf. top
			Perf. bottom

Open Flow _____ /10ths Water in _____ Inch
 _____ /10ths Merc. in _____ Inch
 Volume _____ Cu. Ft.
 Rock Pressure _____ lbs. _____ hrs.
 Oil _____ bbls., 1st 24 hrs.
 Fresh water _____ feet _____ feet
 Salt water _____ feet _____ feet

CASING CEMENTED _____ SIZE _____ No. Ft. _____ Date _____
 COAL WAS ENCOUNTERED AT _____ FEET _____ INCHES
 _____ FEET _____ INCHES FEET _____ INCHES
 _____ FEET _____ INCHES FEET _____ INCHES

Formation	Color	Hard or Soft	Top	Bottom	Oil, Gas or Water	Depth Found	Remarks
Various Formations			00	578			
Cow Run Sand			578	810			
Slate			810	825			
Salt Sand			825	1100			Hole full of water at 910'
Red Rock			1100	1104			
Black Slate			1104	1130			
Shells and Slate			1130	1130			
Sand			1130	1138			
Lime			1138	1197			
Red Rock			1197	1201			
Slate			1201	1210			
Maxon Sand			1210	1235			
Slate			1235	1245			
Little Lime			1245	1275			
Pencil Cave			1275	1292			
Lime			1292	1309			
Break (black)			1309	1312			
Big Lime			1312	1462			
Slate			1462	1495			
Weir Sand			1495	1715			Gas 1,000,000 cu. ft. at 162'
Total Depth				1715'			Oil 1697' to 1715' - also Big Gas Gas about 10,000,000 cu. ft. Oil about 75 bbls per day

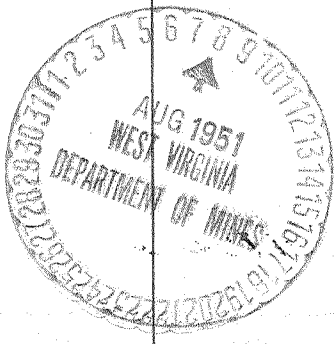

(Over)

AUG 27 1951