

New Location
 Drill Deeper
 Abandonment

Company KREBS OIL CO., INC.
 Address CHARLESTON NAT. BANK BLDG.
 Farm W.D. LEWIS CHAS. W. VA.
 Tract _____ Acres 6.5 Lease No. _____
 Well (Farm) No. _____ Serial No. 1145
 Elevation (Spirit Level) AS ABOVE
 Quadrangle CHARLESTON
 County KANAWHA District ELK
 Engineer C. E. Krebs
 Engineer's Registration No. 773
 File No. _____ Drawing No. _____
 Date 10-18-51 Scale 1"-660'

STATE OF WEST VIRGINIA
 DEPARTMENT OF MINES
 OIL AND GAS DIVISION
 CHARLESTON

WELL LOCATION MAP

FILE NO. KAN-914-A-#1210
KAN-915-A-#1145

+ Denotes location of well on United States Topographic Maps, scale 1 to 62,500, latitude and longitude lines being represented by border lines as shown.

- Denotes one inch spaces on border line of original tracing.

6-0-0

W. D. LEWIS (BLK) NO. 6 WELL.

SP 145

915A

Blk District, Kanawha County, W. Va.
 By Krebs Oil Co., Box 213, Charleston, W. Va.
 Abandoned under permit Kan-.....-A?

On 615 acres, on Mill Creek.

Elevation, 1145' - L. 810

Drilling commenced Dec. 20, 1920; completed Feb. 12, 1921.

Shot Jan. 25, 1922, at 1786-1815', with 50 qts.

8 1/2" casing, 240'; 6 3/8" casing 1605'; all left in.

Oil well. Record to Dept. of Mines stamped Nov. 9, 1951.

Record to RGT from Mrs. Griffith Feb. 29, 1952. Old File No. 1645.

	Top.	Bottom.
Soil	0	14
Sand (hole full water at 20')	14	30
Slate and shells	30	60
Sand	60	160
Slate	160	200
Sand	200	230
Slate and shells	230	300
Sand	300	450
Slate	450	500
Lime	500	570
Salt Sand (hole full water at 720')	570	1180
Lime	1180	1230
Maxton Sand	1230	1250
Lime	1250	1310
Slate	1310	1340
Lime	1340	1380
Slate	1380	1400
Big Lime	1400	1585
Big Injun Sand	1585	1605
Lime	1605	1645
Slate	1645	1680
Sand (show of gas at 1695')	1680	1700
Slate and shells	1700	1760
Weir Sand (show of oil at 1785'; oil, 1803')	1760	1815
Total depth		1815



STATE OF WEST VIRGINIA
DEPARTMENT OF MINES
OIL AND GAS DIVISION

1645

WELL RECORD

Permit No. KAN-915-A

Oil or Gas Well _____ (KIND)


Company Krebs Oil Company
Address P.O. Box #213, Charleston, W.Va.
Farm W. D. Lewis (Elk) Acres 615
Location (waters) Mill Creek
Well No. 6 Elev. 1145
District Elk County Kanawha
The surface of tract is owned in fee by _____
Address _____
Mineral rights are owned by _____
Address _____
Drilling commenced December 20, 1920
Drilling completed February 12, 1921
Date Shot 1/25/22 From 1786 To 1815
With 50 qts.
Open Flow _____ /10ths Water in _____ Inch
_____ /10ths Merc. in _____ Inch
Volume _____ Cu. Ft.
Rock Pressure _____ lbs. _____ hrs.
Oil _____ bbls., 1st 24 hrs.
Fresh water _____ feet _____ feet
Salt water _____ feet _____ feet

Casing and Tubing	Used in Drilling	Left in Well	Packers
Size			Kind of Packer
16			
13			
10			Size of
8 1/4	240'	240'	
6 3/8	1605'	1605'	Depth set
5 3/16			
3			Perf. top
2			Perf. bottom
Liners Used			Perf. top
			Perf. bottom

CASING CEMENTED _____ SIZE _____ No. Ft. _____ Date _____

COAL WAS ENCOUNTERED AT _____ FEET _____ INCHES
_____ FEET _____ INCHES _____ FEET _____ INCHES
_____ FEET _____ INCHES _____ FEET _____ INCHES

Formation	Color	Hard or Soft	Top	Bottom	Oil, Gas or Water	Depth Found	Remarks
Soil				14			
Sand			14	30	Hole full water at		20'
Slate and Shells			30	60			
Sand			60	160			
Slate			160	200			
Sand			200	230			
slate and Shells			230	300			
Sand			300	450			
Slate			450	500			
Lime			500	570	Hole full water at		720'
Sand, Salt			570	1180			
Lime			1180	1230			
Lime Sand - Maxton			1230	1250			
Lime			1250	1310			
Slate			1310	1340			
Lime			1340	1380			
Slate			1380	1400			
Lime - Big			1400	1585			
Sand - Injun			1585	1605			
Lime			1605	1645			
Slate			1645	1680			
Sand			1680	1700	Show of Gas at		1695'
Slate and Shells			1700	1760	" Oil at		1785'
Sand - Weir			1760	1815			1803'
TOTAL DEPTH				1815'			

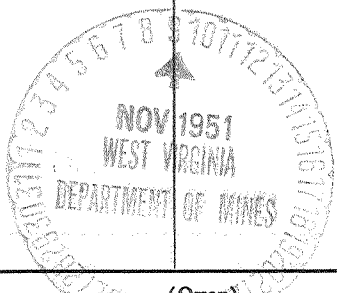

(Over)
FEB 29 1952