

New Location
 Drill Deeper
 Abandonment

APR 26 1954

Company UNITED FUEL GAS CO.
 Address CHARLESTON, W.VA.
 Farm WILLIAM COBB
 Tract _____ Acres 81 Lease No. 11429
 Well (Farm) No. 6 Serial No. 1085
 Elevation (Spirit Level) 816.80'
 Quadrangle CLENDENIN
 County KANAWHA District BIG SANDY
 Engineer Lybert R. Jewell
 Engineer's Registration No. 2529
 File No. 74-69 Drawing No. _____
 Date 4-6-54 Scale 1"=400'

STATE OF WEST VIRGINIA
 DEPARTMENT OF MINES
 OIL AND GAS DIVISION
 CHARLESTON

WELL LOCATION MAP
 FILE NO. KAN-1023-A

+ Denotes location of well on United States Topographic Maps, scale 1 to 62,500, latitude and longitude lines being represented by border lines as shown.

- Denotes one inch spaces on border line of original tracing.

WILLIAM COBB No. 6 (1085) - U, F, G, Co, - KAN-1023-A



STATE OF WEST VIRGINIA
DEPARTMENT OF MINES
OIL AND GAS DIVISION

1871

Quadrangle Clendenin

WELL RECORD

Oil or Gas Well Gas
(KIND)

Permit No. 10734


Company UNITED FUEL GAS COMPANY
Address P.O. Box 1273, Charleston 25, W. Va.
Farm W. M. Cobb #6 Acres 81
Location (waters) Doctors Creek
Well No. 1085 Elev. 816.8'
District Big Sandy County Kanawha
The surface of tract is owned in fee by _____
Address _____
Mineral rights are owned by Gail Rollins, et al
Address Elkview, W. Va.
Drilling commenced July 21, 1919
Drilling completed Sept. 6, 1919
Date Shot 9-6-29 From 1951 To 1957
With Torpedo - 30
Open Flow 22 /10ths Water in _____ Inch
2 /10ths Merc. in _____ Inch
Volume 800,000 Cu. Ft.
Rock Pressure 260 lbs. _____ hrs.
Oil _____ bbls., 1st 24 hrs.
Fresh water 90 feet 1020 feet
Salt water 1100 feet _____ feet

Casing and Tubing	Used in Drilling	Left in Well	Packers
Size			
16			Kind of Packer
18			<u>Parmaco Anchor</u>
10		<u>20'</u>	Size of
8 1/2		<u>350'</u>	<u>2x6-5/8"</u>
6 5/8		<u>1610'</u>	Depth set
5 3/16			<u>1853'</u>
3			Perf. top
2		<u>1991'6"</u>	Perf. bottom
Liners Used			Perf. top
			Perf. bottom

CASING CEMENTED _____ SIZE _____ No. Ft. _____ Date _____

COAL WAS ENCOUNTERED AT 345 FEET 24 INCHES
425 FEET 36 INCHES FEET INCHES
FEET INCHES FEET INCHES

Formation	Color	Hard or Soft	Top	Bottom	Oil, Gas or Water	Depth Found	Remarks
Red Rock			0	275			
Sand			275	345			
Coal			345	347			
Sand			347	425			
Coal			425	428			
Lime			428	450			
Sand			450	475			
Slate			475	490			
Lime			490	520			
Sand			520	550			
Lime Shell			550	630			
Sand			630	665			
Lime Shell			665	765			
Sand			765	785			
Lime Shell			785	865			
Sand			865	900			
Lime Shell			900	990			
Gas Sand			990	1025			
Gas			1010				
Lime			1025	1045			
Salt Sand			1045	1400			
Lime			1400	1455			
Maxon			1455	1565			
Little Lime			1565	1600			
Pencil Cave			1600	1605			
Big Lime			1605	1727			
Show gas			1633				
Big Injun			1727	1767			
Gas			1731	1767	Water 90		
Slate			1767	1795	Water 1020		
Lime Shells			1795	1845	Water 1100 Hole full		
Slate			1845	1951			
Weir			1951	1976			
Oil			1951	1957			
Lime			1976	2059			
Total depth			2059'				
Steel Lime			1951				
Present depth of hole			1969 S.L.				

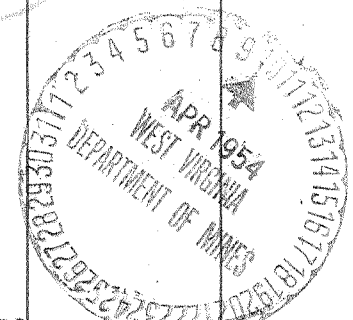

JAN 7 1955

