

New Location...   
 Drill Deeper.....   
 Abandonment.....

✓ AUG 8 1954  
 3,3 W  
 0.75 R

Company UNITED FUEL GAS CO.  
 Address CHARLESTON, W. VA.  
 Farm HENRY ALLEN, HRS.  
 Tract \_\_\_\_\_ Acres 12 1/3 Lease No. 12562  
 Well (Farm) No. \_\_\_\_\_ Serial No. 635  
 Elevation (Spirit Level) 816.0'  
 Quadrangle GLENDENIN  
 County KANAWHA District BIG SANDY  
 Engineer Seybert R. Ferrell  
 Engineer's Registration No. 2529  
 File No. 74-67 Drawing No. \_\_\_\_\_  
 Date 7-26-54 Scale 1"=400'

STATE OF WEST VIRGINIA  
 DEPARTMENT OF MINES  
 OIL AND GAS DIVISION  
 CHARLESTON

WELL LOCATION MAP  
 FILE NO. KAN-1057-A

+ Denotes location of well on United States Topographic Maps, scale 1 to 62,500, latitude and longitude lines being represented by border lines as shown.  
 - Denotes one inch spaces on border line of original tracing.



STATE OF WEST VIRGINIA  
DEPARTMENT OF MINES  
OIL AND GAS DIVISION

1857

Quadrangle Clendenin

Permit No. 1057-4

WELL RECORD

Oil or Gas Well Gas  
(KIND)

Company UNITED FUEL GAS CO.  
Address P.O. Box 1273, Charleston 25, W. Va.  
Farm Henry Allen Heirs Acres 12-1/3  
Location (waters) Jordans Creek  
Well No. 635 Elev. 816'  
District Big Sandy County Kanawha  
The surface of tract is owned in fee by \_\_\_\_\_  
Address \_\_\_\_\_  
Mineral rights are owned by Willa Jackson, et al  
Address Clendenin, W. Va.  
Drilling commenced 8-28-14  
Drilling completed 10-3-14  
Date Shot \_\_\_\_\_ From \_\_\_\_\_ To \_\_\_\_\_  
With \_\_\_\_\_  
Open Flow 5 /10ths Water in 6-5/8" Inch  
\_\_\_\_\_ /10ths Merc. in \_\_\_\_\_ Inch  
Volume 1,117,000 Cu. Ft.  
Rock Pressure 360 lbs. 18 hrs.  
Oil \_\_\_\_\_ bbls., 1st 24 hrs.  
Fresh water \_\_\_\_\_ feet \_\_\_\_\_ feet  
Salt water \_\_\_\_\_ feet \_\_\_\_\_ feet


Casing and Tubing	Used in Drilling	Left in Well	Packers
Size			
16		16'	Kind of Packer
13			<u>Callanan</u>
10			Size of
8 1/4	530'		<u>2x6-5/8x16</u>
6 3/4		1621'	Depth set
5 3/16			
3			Perf. top
2		1802-6/12'	Perf. bottom
Liners Used			Perf. top
			Perf. bottom

CASING CEMENTED \_\_\_\_\_ SIZE \_\_\_\_\_ No. Ft. \_\_\_\_\_ Date \_\_\_\_\_

COAL WAS ENCOUNTERED AT \_\_\_\_\_ FEET \_\_\_\_\_ INCHES  
\_\_\_\_\_ FEET \_\_\_\_\_ INCHES FEET \_\_\_\_\_ INCHES  
\_\_\_\_\_ FEET \_\_\_\_\_ INCHES FEET \_\_\_\_\_ INCHES

Formation	Color	Hard or Soft	Top	Bottom	Oil, Gas or Water	Depth Found	Remarks
Slate			14	40			
Sand			40	400			
Slate			400	460			
Sand			460	690			
Slate			690	725			
Sand			725	800			
Slate			800	845			
Sand			845	890			
Slate			890	1000			
Salt Sand			1000	1390			
Slate			1390	1454			
Sand			1454	1470			
Slate			1470	1485			
Red Rock			1485	1500			
Slate			1500	1536			
Maxon Sand			1536	1550			
Little Lime			1550	1580			
Pencil Cave			1580	1585			
Big Lime			1585	1718			
Big Injun			1718	1753			
Slate			1753	1781			
Total depth			1781'				

Hole reduced to 5" at 1714'  
Show of gas at 1712'  
Gas 1718' to 1748'

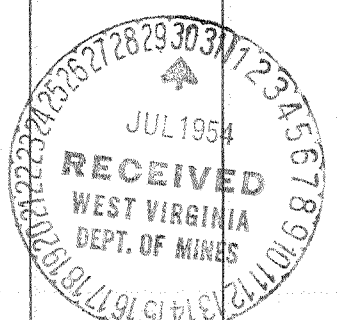

APR 22 1955

