

Company UNITED FUEL GAS CO.
 Address CHARLESTON, W. VA.
 Farm FANNIE D. BOYD
 Tract _____ Acres 410 Lease No. 16466
 Well (Farm) No. 3 Serial No. 1443
 Elevation (Spirit Level) 1072.10'
 Quadrangle MONTGOMERY
 County KANAWHA District CABIN CREEK
 Engineer Paul E. Johnston
 Engineer's Registration No. 669
 File No. 68-49 Drawing No. _____
 Date 8-20-54 Scale 1" = 800'

STATE OF WEST VIRGINIA
 DEPARTMENT OF MINES
 OIL AND GAS DIVISION
 CHARLESTON

WELL LOCATION MAP
 FILE NO. KAN-1101-A

+ Denotes location of well on United States Topographic Maps, scale 1 to 62,500, latitude and longitude lines being represented by border lines as shown.

- Denotes one inch spaces on border line of original tracing.

6-6 241

IMPERIAL TRACING CLOTH
 K & E CO., N. Y.

FANNIE D. BOYD No 2 (1443) U.F.G. Co KAN-1101-A



STATE OF WEST VIRGINIA
DEPARTMENT OF MINES
OIL AND GAS DIVISION

1907

WELL RECORD


Oil or Gas Well Gas
(KIND)

Quadrangle Montgomery
Permit No. 11064
Company UNITED FUEL GAS CO.
Address P.O. Box 1273, Charleston 25, W. Va.
Farm Fannie D. Boyd Acres 410
Location (waters) Dickinson Branch
Well No. 1443 Elev. 1072.10'
District Cabin Creek County Kanawha
The surface of tract is owned in fee by _____
Address _____
Mineral rights are owned by Kan. Valley Bank-Trustee
of Fannie D. Boyd Estate Address Charleston, W.Va.
Drilling commenced 3-9-25
Drilling completed 4-27-25
Date Shot 4-27-25 From _____ To _____
With 20 qts.
Open Flow 10 /10ths Water in _____ 2 Inch
/10ths Merc. in _____ Inch
Volume 150,000 Cu. Ft.
Rock Pressure 335 lbs. _____ hrs.
Oil _____ bbls., 1st 24 hrs.
Fresh water _____ feet
Salt water 1000 feet

Casing and Tubing	Used in Drilling	Left in Well	Packers
Size			Kind of Packer
16			Anchor
13		14'	
10			Size of
8 1/4		590'	3x6-5/8x16
6 5/8		1756'	Depth set
5 3/16			1969'
3		2180'	Perf. top
2			Perf. bottom
Liners Used			Perf. top
			Perf. bottom

CASING CEMENTED _____ SIZE _____ No. Ft. _____ Date _____
COAL WAS ENCOUNTERED AT 50 FEET 24 INCHES
155 FEET 48 INCHES 300 FEET 48 INCHES
FEET INCHES FEET INCHES

Formation	Color	Hard or Soft	Top	Bottom	Oil, Gas or Water	Depth Found	Remarks
Clay			0	14	Water - hole full 155'		
Sand			14	30	Water - hole full 1000'		
Slate			30	50	Gas show no test 1900'		
Coal			50	52	Gas show no test - 2016-2020'		
Slate			52	75	Gas 2046-2050		
Sand			75	100			
Lime			100	140			
Slate			140	155			
Coal			155	159	Shot did not affect gas.		
Sand			159	200			
Slate			200	250			
Sand			250	300			
Coal			300	304			
Lime			304	350			
Sand			350	450			
Slate			450	500			
Sand			500	650			
Lime			650	700			
Sand			700	850			
Slate			850	900			
Salt Sand			900	1050			
Shells-Slate			1050	1100			
Salt Sand			1100	1300			
Slate			1300	1305			
Red Rock			1305	1310			
Lime			1310	1360			
Maxon Sand			1360	1480			
Slate			1480	1500			
Red Rock			1500	1520			
Slate-Shells			1520	1680			
Little Lime			1680	1720			
Slate			1720	1735			
Slate Cave			1735	1738			
Big Lime			1738	1921			
Big Injun Sand			1921	1956			
Lime			1956	1966			
Weir Sand			1966	2164			
Total depth			2164'				

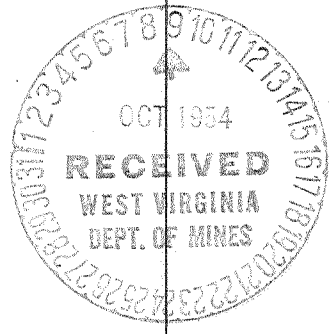

AUG 12 1955

