

Company UNITED FUEL GAS CO.  
 Address CHARLESTON, W.VA.  
 Farm WILSON WOODS  
 Tract \_\_\_\_\_ Acres 200 Lease No. 2145  
 Well (Farm) No. \_\_\_\_\_ Serial No. 1579  
 Elevation (Spirit Level) 698.3'  
 Quadrangle WALTON  
 County KANAWHA District BIG SANDY  
 Engineer Seibert Russell  
 Engineer's Registration No. 2529  
 File No. 76-69 Drawing No. \_\_\_\_\_  
 Date 10-8-54 Scale 1"=400'

STATE OF WEST VIRGINIA  
 DEPARTMENT OF MINES  
 OIL AND GAS DIVISION  
 CHARLESTON

WELL LOCATION MAP  
 FILE NO. KAN-1108-A

+ Denotes location of well on United States Topographic Maps, scale 1 to 62,500, latitude and longitude lines being represented by border lines as shown.

- Denotes one inch spaces on border line of original tracing.

6-6 220

WILSON WOODS No. 1579 - U.F.G.CO. - KAN-1108-A



STATE OF WEST VIRGINIA  
DEPARTMENT OF MINES  
OIL AND GAS DIVISION

1960

WELL RECORD

Gas

Oil or Gas Well (KIND)


Quadrangle Walton  
Permit No. 11084  
Company UNITED FUEL GAS CO.  
Address P.O. Box 1273, Charleston 25, W. Va.  
Farm Wilson Wood Acres 1579  
Location (waters) Big Sandy Creek  
Well No. 1579 Elev. 698.3'  
District Big Sandy County Kanawha  
The surface of tract is owned in fee by \_\_\_\_\_  
Address \_\_\_\_\_  
Mineral rights are owned by Ellet Bird, et al - Farmers  
& Citizens State Bank Address Clendenin, W. Va.  
Drilling commenced 3-23-26  
Drilling completed 4-28-26  
Date Shot \_\_\_\_\_ From \_\_\_\_\_ To \_\_\_\_\_  
With \_\_\_\_\_  
Open Flow 42 /10ths Water in \_\_\_\_\_ 2 Inch  
\_\_\_\_\_ /10ths Merc. in \_\_\_\_\_ Inch  
Volume 310,000 Cu. Ft.  
Rock Pressure 95 lbs. \_\_\_\_\_ hrs.  
Oil \_\_\_\_\_ bbls., 1st 24 hrs.  
Fresh water 225 feet 240 feet  
Salt water 995 feet \_\_\_\_\_ feet

Casing and Tubing	Used in Drilling	Left in Well	Packers
Size			
16			Kind of Packer <u>OWS</u>
13			<u>Anchor</u>
10			Size of _____
8 1/4	<u>480'</u>		<u>5x5-3/16"</u>
6 1/2		<u>1503'6"</u>	Depth set _____
5 3/16			<u>1587</u>
3		<u>1681'10"</u>	Perf. top _____
2			Perf. bottom _____
Liners Used			Perf. top _____
			Perf. bottom _____

CASING CEMENTED \_\_\_\_\_ SIZE \_\_\_\_\_ No. Ft. \_\_\_\_\_ Date \_\_\_\_\_

COAL WAS ENCOUNTERED AT 225 FEET 60 INCHES  
450 FEET 60 INCHES FEET INCHES  
FEET INCHES FEET INCHES

Formation	Color	Hard or Soft	Top	Bottom	Oil, Gas or Water	Depth Found	Remarks
Sand & Slate			0	225	Water at 225'		
Coal			225	230	Hole full at 240'		
Sand & Slate			230	450	Hole full water 995'		
Coal			450	455	Gas & Small show water 1550'		
Sand & Slate			455	900	Hole reduced to 5-3/16" at 1565'		
Sand			900	925	Small show oil & gas 1580'		
Slate			925	935	First and only pay 1608 to 1609'		
Salt Sand			935	1280			
Slate & Shells			1280	1304			
Maxon Sand			1304	1412			
Little Lime			1412	1444			
break			1444	1446			
Lime Shell			1446	1463			
break			1463	1464			
Big Lime			1464	1589			
Big Injun Sand			1589	1638			
Slate			1638	1660			
Total depth			1660'				

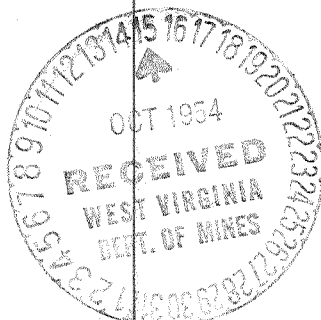

JAN 23 1956

Formation	Color	Hard or Soft	Top	Bottom	Oil, Gas or Water	Depth Found	Remarks

Date October 13, 19 54

APPROVED UNITED FUEL GAS CO., Owner

By S. R. Furell  
 (Title)

Mgr. Civil Engr. Dept.