

- New Location
- Drill Deeper
- Abandonment

DEC 21 1954

Company UNITED FUEL GAS CO.
 Address CHARLESTON, W. VA.
 Farm D. C. TAYLOR
 Tract _____ Acres 400 Lease No. 4548
 Well (Farm) No. 1 Serial No. 555
 Elevation (Spirit Level) 650.
 Quadrangle WALTON
 County KANAWHA District BIG SANDY
 Engineer Joseph H. Russell
 Engineer's Registration No. 2529
 File No. 76-69 Drawing No. _____
 Date 11-24-54 Scale 1" = 400'

STATE OF WEST VIRGINIA
 DEPARTMENT OF MINES
 OIL AND GAS DIVISION
 CHARLESTON

WELL LOCATION MAP
 FILE NO. KAN-1154-A

+ Denotes location of well on United States Topographic Maps, scale 1 to 62,500, latitude and longitude lines being represented by border lines as shown.
 — Denotes one inch spaces on border line of original tracing.

6-6 220



STATE OF WEST VIRGINIA
DEPARTMENT OF MINES
OIL AND GAS DIVISION

1874

Quadrangle Walton

WELL RECORD

Permit No. 157A

Oil or Gas Well Gas
(KIND)

Company UNITED FUEL GAS CO.
Address P.O. Box 1273, Charleston 25, W. Va.
Farm D. C. Taylor Acres 400
Location (waters) Big Thoroughfare Run
Well No. 555 Elev. 650'
District Big Sandy County Kanawha

The surface of tract is owned in fee by _____
Address _____

Mineral rights are owned by Beverly J. Taylor, et al
2729 N.W. 66th St. Address Oklahoma City, Okla.

Drilling commenced 5-15-13
Drilling completed 7-9-13

Date Shot _____ From _____ To _____
With _____

Open Flow 16 /10ths Water in 6-5/8 Inch
_____ /10ths Merc. in _____ Inch

Volume 2,007,720 Cu. Ft.

Rock Pressure 480 lbs. _____ hrs.

Oil _____ bbls., 1st 24 hrs.

Fresh water _____ feet _____ feet


Salt water 900 feet 920 feet

Casing and Tubing	Used in Drilling	Left in Well	Packers
Size			
16		16'	Kind of Packer <u>Callanan</u>
13			
10	25'		Size of <u>2x6-5/8x20</u>
8 1/2	555'		Depth set <u>1486'</u>
6 3/4	1418'	1605'	
5 3/16			Perf. top
3		1662' 6"	Perf. bottom
2			Perf. top
Liners Used			Perf. bottom

CASING CEMENTED _____ SIZE _____ No. Ft. _____ Date _____

COAL WAS ENCOUNTERED AT 402 FEET 60 INCHES
523 FEET 72 INCHES _____ FEET _____ INCHES
_____ FEET _____ INCHES _____ FEET _____ INCHES

Formation	Color	Hard or Soft	Top	Bottom	Oil, Gas or Water	Depth Found	Remarks
Conductor			16				
Sand			25	120			
Shells & Lime			120	182			
Sand			182	260			
Lime			260	300			
Sand			300	402			
Coal			402	407			
Sand			407	457			
Lime			457	475			
Sand			475	523			
Coal			523	529			
Lime & Shells			529	555			
Sand			555	660			
Lime & Shells			660	790			
Lime			790	817			
Salt Sand			817	1160			
Lime & Shells			1160	1247			Water at 900'
Maxon Sand			1247	1370			Hole full water at 920'
Slate			1370	1372			
Little Lime			1372	1407			
Pencil Cave			1407	1412			
Big Lime			1412	1529			
Big Injun			1529	1555			Gas 1530' to 1554'
Lime & Shells			1555	1925			
Total depth			1925'				
Hole filled up to			1649'				

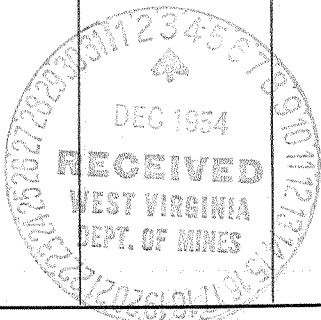

JAN 7 1955

