

New Location...   
 Drill Deeper.....   
 Abandonment.....

E. GEBHART 914 ± FEB. 6 1956

R. P. SKINNER, 2 CONGRESS ST., BELFAST, MAINE - COAL OWNER

Company	RICHARD JACKSON
Address	CHARLESTON, W. VA.
Farm	ROBERT P. SKINNER
Tract	Acres 100 Lease No.
Well (Farm) No.	2 Serial No. F-1812
Elevation (Spirit Level)	861.1
Quadrangle	CLENDENIN
County	KANAWHA District ELK
Engineer	PAUL E. JOACHIM
Engineer's Registration No.	669
File No.	72-65 Drawing No.
Date	JAN. 21, 1956 Scale 1" = 800'

STATE OF WEST VIRGINIA  
 DEPARTMENT OF MINES  
 OIL AND GAS DIVISION  
 CHARLESTON

WELL LOCATION MAP  
 FILE NO. KAN-1225-A

+ Denotes location of well on United States Topographic Maps, scale 1 to 62,500, latitude and longitude lines being represented by border lines as shown.

- Denotes one inch spaces on border line of original tracing.

6-0217

ROBERT P. SKINNER No. 2 (F-1812) - RICHARD JACKSON - KAN 1225-A



STATE OF WEST VIRGINIA  
DEPARTMENT OF MINES  
OIL AND GAS DIVISION

1987

Formerly: South Penn Oil Company

WELL RECORD

Permit No. 125-A

Company Wilhelm and Jackson  
Address Hamlin, West Virginia  
Farm Robert P. Skinner Acres 100  
Location (waters) \_\_\_\_\_  
Well No. No. 2 Elev. 861.1  
District Slk County Kanawha  
The surface of tract is owned in fee by \_\_\_\_\_  
Address \_\_\_\_\_  
Mineral rights are owned by \_\_\_\_\_  
Address \_\_\_\_\_  
Drilling commenced June 22, 1914  
Drilling completed August 5, 1914  
Date Shot 1915 & 1927 From 1918' To 1927'  
With \_\_\_\_\_  
Open Flow /10ths Water in \_\_\_\_\_ Inch  
/10ths Merc. in \_\_\_\_\_ Inch  
Volume \_\_\_\_\_ Cu. Ft.  
Rock Pressure \_\_\_\_\_ lbs. \_\_\_\_\_ hrs.  
Oil \_\_\_\_\_ bbls., 1st 24 hrs.  
Fresh water \_\_\_\_\_ feet \_\_\_\_\_ feet  
Salt water \_\_\_\_\_ feet \_\_\_\_\_ feet

Oil or Gas Well Oil  
(KIND)

Casing and Tubing	Used in Drilling	Left in Well	Packers
Size			Kind of Packer
16			<u>B. &amp; H.</u>
13			<u>on 6-5/8" casing</u>
10			Size of
8 1/4		<u>429'</u>	
6%		<u>1511'</u>	Depth set
5 3/16			
3			Perf. top
2			Perf. bottom
Liners Used			Perf. top
			Perf. bottom


CASING CEMENTED \_\_\_\_\_ SIZE \_\_\_\_\_ No. Ft. \_\_\_\_\_ Date \_\_\_\_\_

COAL WAS ENCOUNTERED AT \_\_\_\_\_ FEET \_\_\_\_\_ INCHES  
\_\_\_\_\_ FEET \_\_\_\_\_ INCHES \_\_\_\_\_ FEET \_\_\_\_\_ INCHES  
\_\_\_\_\_ FEET \_\_\_\_\_ INCHES \_\_\_\_\_ FEET \_\_\_\_\_ INCHES

Formation	Color	Hard or Soft	Top	Bottom	Oil, Gas or Water	Depth Found	Remarks
Conductor			0	16			
Red Rock			16	40			
Sand			40	125			
Slate			125	160			
SALT SAND			840	1330			Water - hole full - 920' to 935'
Maxon Sand			1439	1469			
LITTLE LIME			1474	1509			
Big Lime			1531	1681			Gas 1571'
Pencil Cave			1524	1531			Oil 1850'
Weir Sand			1800	1935			2nd Oil - 1891'
							Oil 1908'
							Oil 1920' to 1934'
Total Depth				1938			

SHOT RECORD

DATE	SIZE SHOT	TOP SHELL
11/10/15	40	1918'
8/3/27	20	1927'

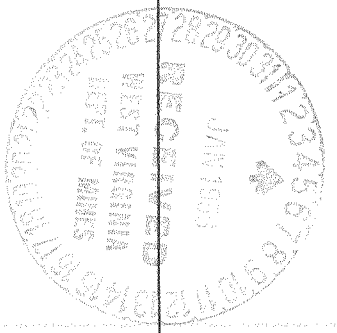

OCT. 6 1956