

New Location ..
 Drill Deeper
 Abandonment

JUL 31 1960

0.31 W
 5.4 D

| | |
|-----------------------------|------------------------------|
| Company | FOSTER MAYS |
| Address | KENNA, W. VA. |
| Farm | J. V. R. SKINNER |
| Tract | Acres 346 Lease No. 60925 |
| Well (Farm) No. | 7 Serial No. F-1803 |
| Elevation (Spirit Level) | 820' |
| Quadrangle | CLENDENIN |
| County | KANAWHA District ELK |
| Engineer | PAUL E. JOACHIM |
| Engineer's Registration No. | 669 |
| File No. | 72-63 Drawing No. |
| Date | MAY 25, 1960 Scale 1" = 800' |

STATE OF WEST VIRGINIA
 DEPARTMENT OF MINES
 OIL AND GAS DIVISION
 CHARLESTON

WELL LOCATION MAP
 FILE NO. KAN-1311-A

+ Denotes location of well on United States Topographic Maps, scale 1 to 62,500, latitude and longitude lines being represented by border lines as shown.
 - Denotes one inch spaces on border line of original tracing.

6-0 217

J.V.R. SKINNER 070.7 (F-1803) — FOSTER MAYS — KAN-1311-A



2067

STATE OF WEST VIRGINIA
DEPARTMENT OF MINES
OIL AND GAS DIVISION

Quadrangle Cumberland NW
Permit No. B11A

WELL RECORD

Oil or Gas Well Oil
(KIND)


Company Poster Hoyt, Jr.
 Address Kennas, West Virginia
 Farm J. V. R. Skinner Acres 74
 Location (waters) Elk
 Well No. No. 7 Elev. 820
 District Elk County Kanawha
 The surface of tract is owned in fee by J. V. E. Skinner
 Address Elkview, W. Va.
 Mineral rights are owned by South Penn Natural Gas
 Company Address Parkersburg, W. Va.
 Drilling commenced February, 1915
 Drilling completed May, 1915
 Date Shot From _____ To _____
 With _____
 Open Flow /10ths Water in _____ Inch
 /10ths Merc. in _____ Inch
 Volume _____ Cu. Ft.
 Rock Pressure _____ lbs. _____ hrs.
 Oil _____ bbls., 1st 24 hrs.
 Fresh water 380 feet _____ feet
 Salt water 820 feet _____ feet

| Casing and Tubing | Used in Drilling | Left in Well | Packers |
|-------------------|------------------|--------------|----------------|
| Size | | | |
| 16 | | | Kind of Packer |
| 13 | | | |
| 10 | | | Size of |
| 8 1/4 | <u>554</u> | <u>554</u> | |
| 6 1/2 | <u>1425</u> | <u>1425</u> | Depth set |
| 5 3/16 | | | |
| 3 | | | Perf. top |
| 2 | <u>1835</u> | <u>1835</u> | Perf. bottom |
| Liners Used | | | Perf. top |
| | | | Perf. bottom |

CASING CEMENTED _____ SIZE _____ No. Ft. _____ Date _____

COAL WAS ENCOUNTERED AT _____ FEET _____ INCHES
 _____ FEET _____ INCHES _____ FEET _____ INCHES
 _____ FEET _____ INCHES _____ FEET _____ INCHES

| Formation | Color | Hard or Soft | Top | Bottom | Oil, Gas or Water | Depth Found | Remarks |
|------------------|-------|--------------|------|--------|-------------------|-------------|---------|
| Conductor | | | | 16 | | | |
| Sand | | | 16 | 50 | | | |
| Water | | | 525 | | | | |
| Slate & Sand | | | 530 | 710 | | | |
| Salt Sand | | | 710 | 1215 | | | |
| Oil & Gas (show) | | | 730 | | | | |
| Water | | | 790 | 810 | | | |
| Line | | | 1215 | 1225 | | | |
| Red Rock | | | 1225 | 1273 | | | |
| Slate & Shells | | | 1273 | 1300 | | | |
| Red Rock | | | 1300 | 1325 | | | |
| Maxon Sand | | | 1325 | 1340 | | | |
| Slate | | | 1340 | 1352 | | | |
| Little Line | | | 1352 | 1390 | | | |
| Slate | | | 1390 | 1395 | | | |
| Lime | | | 1395 | 1404 | | | |
| Pencil Slate | | | 1404 | 1414 | | | |
| Big Lime | | | 1414 | 1575 | | | |
| Gas | | | 1500 | | | | |
| Slate & Shells | | | 1575 | 1590 | | | |
| Red Rock | | | 1590 | 1615 | | | |
| Slate & Shell | | | 1615 | 1626 | | | |
| Squaw Sand | | | 1626 | 1745 | | | |
| Gas | | | 1685 | | | | |
| Weir Sand | | | 1745 | | | | |
| Oil | | | 1778 | | | | |
| Oil | | | 1790 | | | | |
| Gas | | | 1805 | | | | |
| Oil (best) | | | 1815 | | | | |
| Total Depth | | | | 1826 | Oil | | |

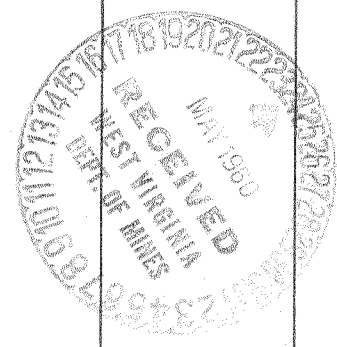

3 1961

| Formation | Color | Hard or Soft | Top | Bottom | Oil, Gas or Water | Depth Found | Remarks |
|-----------|-------|--------------|-----|--------|-------------------|-------------|---------|
| | | | | | | | |
| | | | | | | | |
Date May 4, 1960

APPROVED *(Signature)*, Owner

By *(Signature)*
(Title)