


2

3

Latitude 38° 35'

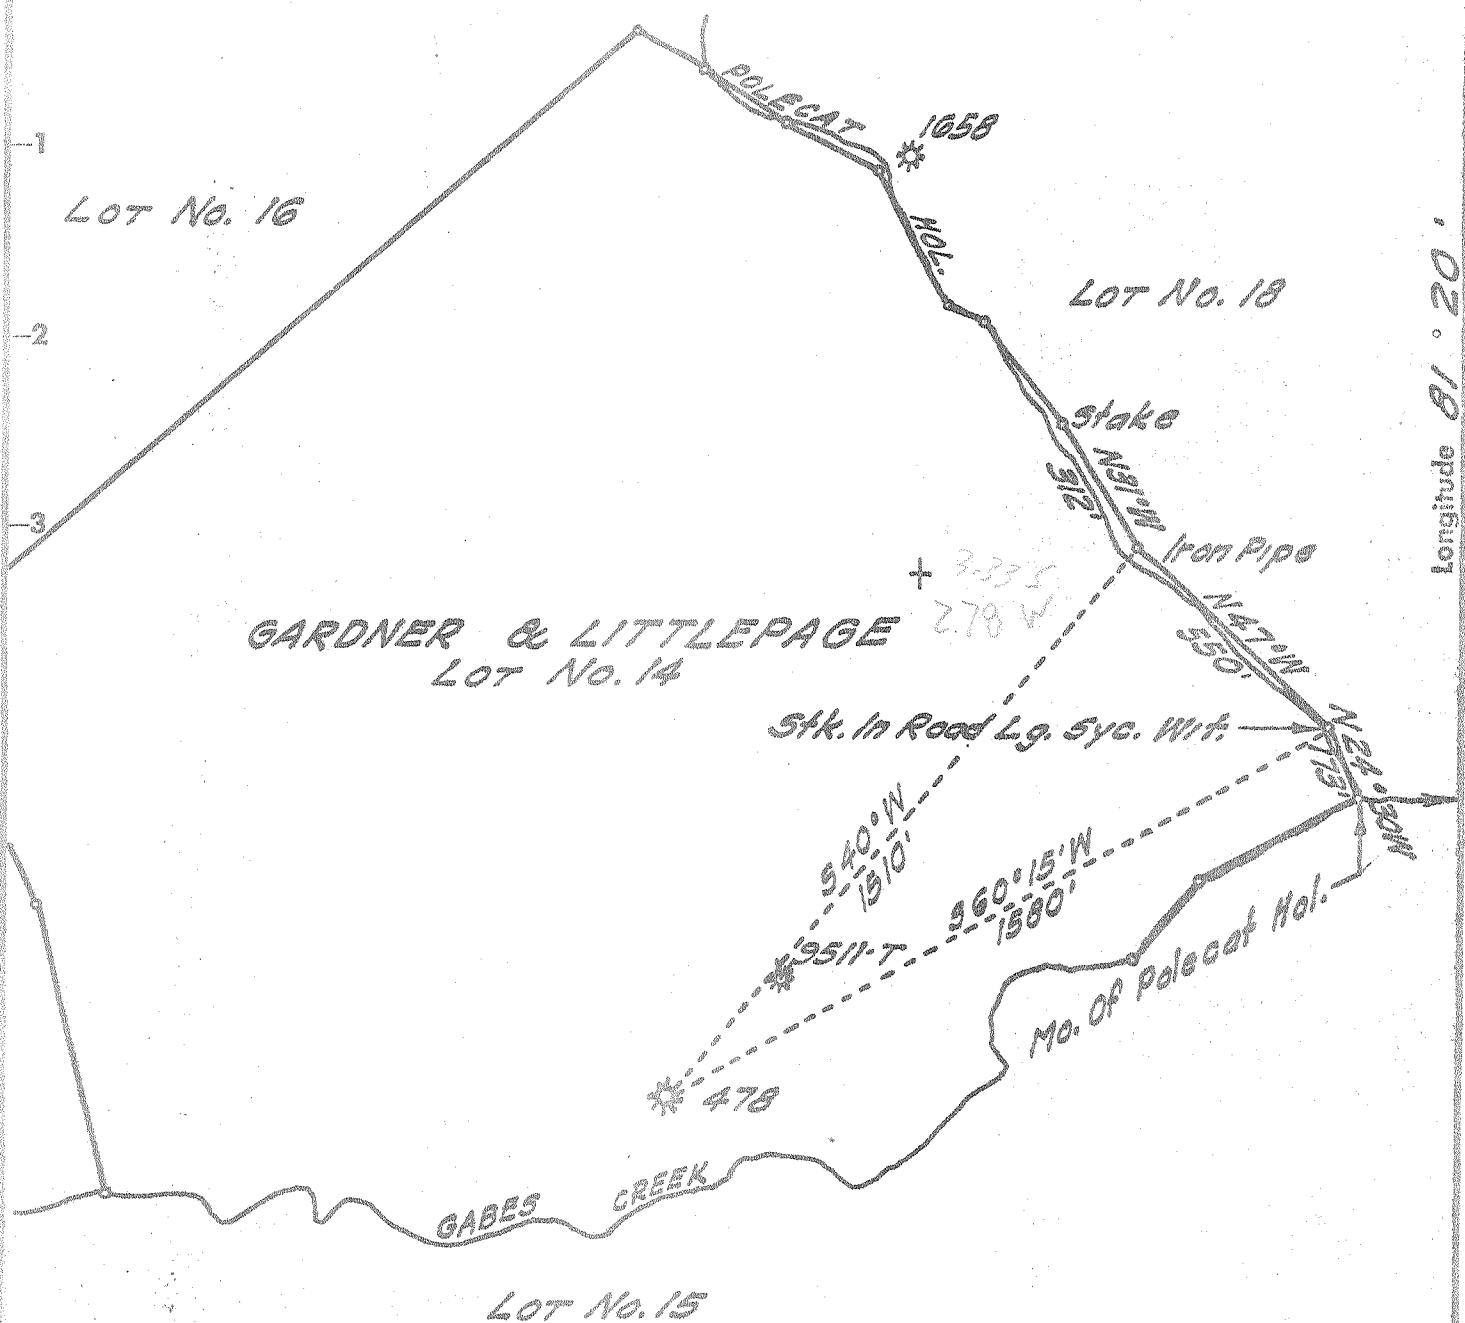

LOT No. 15

BENCH MARK DESCRIPTION

U. E. "Z" Cut in S.E. Edge of Conc. Headwall,
West Side of W. Va. - U.S. Route No. 19 & 14 Across
From Left Hand Grocery Store, in Front of
R. G. Jeff Home. Elev. 632.00'

ACCURACY- One Part in 200

Fracture _____
Before 6/5/29
New Location
Drill Deeper
Redrill
Abandonment

I, the undersigned, hereby certify that this map is correct to the best of my knowledge and belief and shows all the information required by Paragraph 5 of the Rules and Regulations of the Oil and Gas Section of the Mining Laws of West Virginia.

The accuracy of this survey is within the limits and as prescribed in Paragraph 5 by the Oil and Gas Division of the Department of Mines Regulations.

Company UNITED FUEL GAS CO.

Address CHARLESTON, W. VA.

Farm GARDNER & LITTLEPAGE

Tract Acres 1600 Lease No. 592

Well (Farm) No. 3 Serial No. 478

Elevation (Spirit Level) 855.43'

Quadrangle WALTON SC

County KANAWHA District BIG SANDY

Engineer Adrian E. Lehman

Engineer's Registration No. 2330

File No. 74-71 Drawing No. _____

Date 3-10-71 Scale 1" = 400'

STATE OF WEST VIRGINIA

DEPARTMENT OF MINES

OIL AND GAS DIVISION

CHARLESTON

WELL LOCATION MAP

FILE NO. KAN-1408-A

+ Denotes location of well on United States Topographic Maps, scale 1 to 62,500 latitude and longitude lines being represented by border lines as shown.

- Denotes one inch spaces on border line of original tracing.

Longitude 81° 20'