


Topo
Loc. 15'
0.65
3.08 W

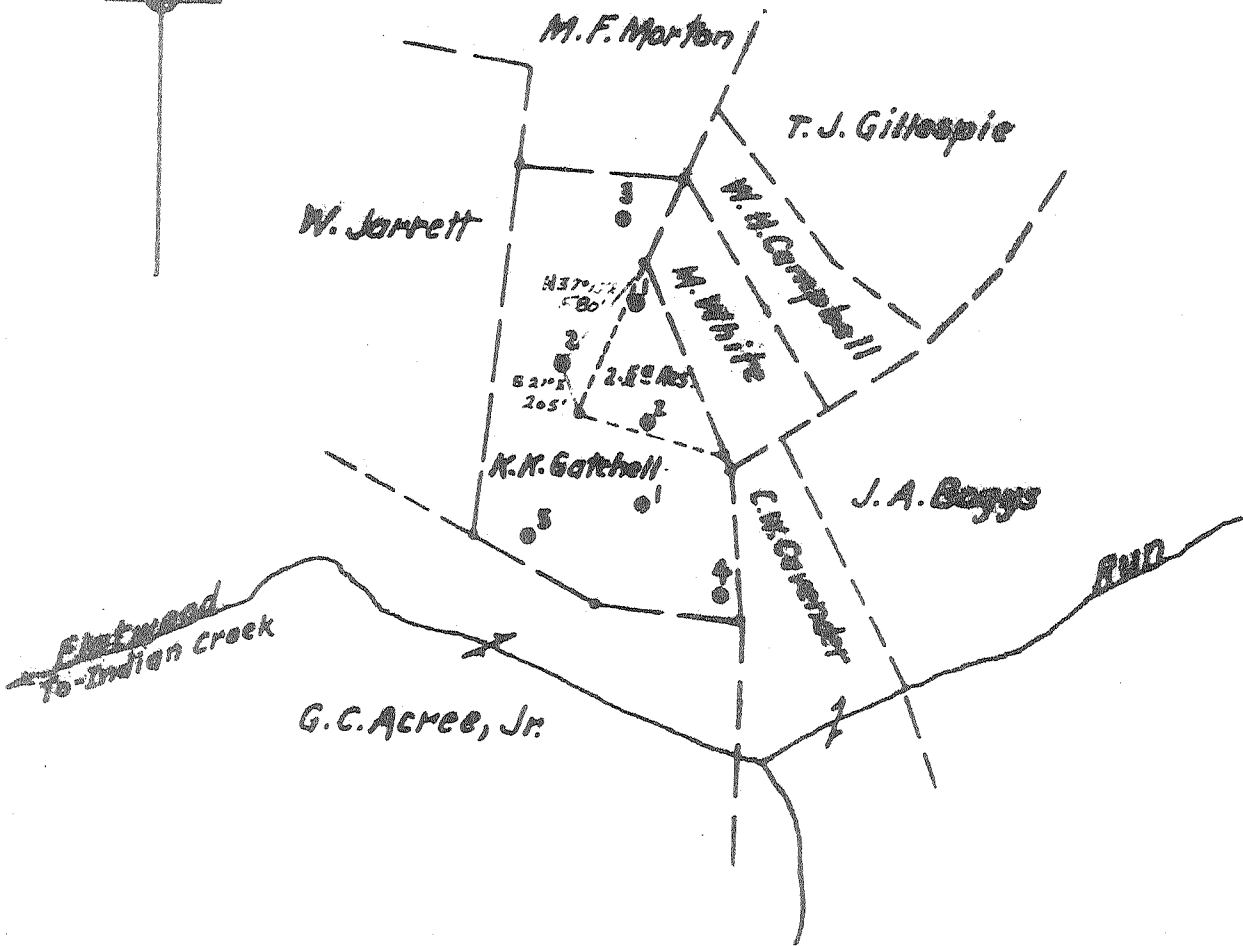

- Fracture
- Before 6/5/29
- New Location
- Ditch/Slipper
- Road
- Abandonment

I, the undersigned, hereby certify that this map is correct to the best of my knowledge and belief and shows all the information required by Paragraph 6 of the Rules and Regulations of the Oil and Gas Section of the Mining Laws of West Virginia.

The accuracy of this survey is within the limits and as prescribed in Paragraph 6 by the Oil and Gas Division of the Department of Mines Regulations.

Source of Error -

Company Blue Creek Gas Co., S.M. Rubin, Agt.

Address E. 23rd St., Charleston, W. Va., 25302

Farm K. R. Gatchell

Tract _____ Acres 30 Lease No. _____

Well (Farm) No. 2 Serial No. _____

Elevation (Spirit Level) 827'

Quadrangle Clendenin WC

County Monroe District E1K

Engineer _____

Engineer's Registration No. _____

File No. 624 Drawing No. _____

Date 2/25/74 Scale 1" = 800'

STATE OF WEST VIRGINIA
DEPARTMENT OF MINES
OIL AND GAS DIVISION
CHARLESTON

WELL LOCATION MAP

FILE NO. KAN-1435-A

↑ Denotes location of well on United States Topographic Maps, scale 1 to 62,500 latitude and longitude lines being represented by border lines as shown.

- Denotes one inch spaces on border line of original tracing.

47 039