


Longitude $81^{\circ} 25'$

C.J. HUNT

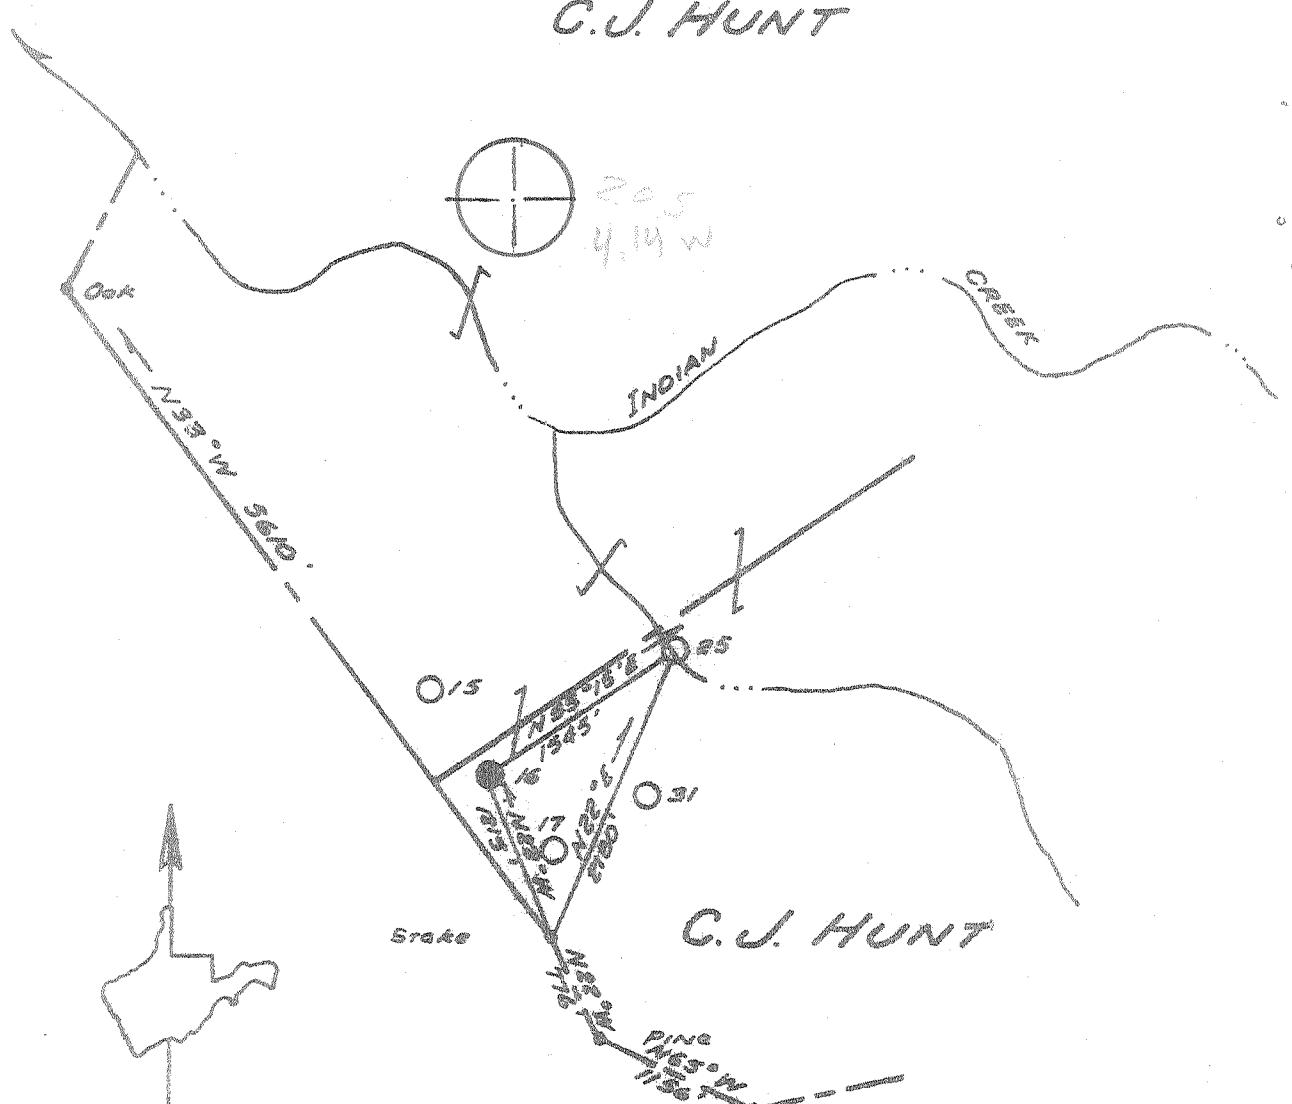

ELK RIVER COAL Co.
(COAL NOT OPERATED)

New Location Drill Deeper Abandonment

Minimum Error of Closure
Source of Elevation WELL No 25, Elev 809'

"I, the undersigned, hereby certify that this map is correct to the best of my knowledge and belief and shows all the information required by paragraph 6 of the rules and regulations of the oil and gas section of the mining laws of West Virginia."

Company W.D. FRAME

Address P.O. Box 263, ELKVIEW W.Va.

Farm C.J. HUNT

Tract Acres 929 Lease No. 27480

Well (Farm) No. 16 Serial No.

Elevation (Spirit Level) 809'

Quadrangle GLENDEENIN WC

County KANAWHA District ELK
MADE FROM COPY OF ORIGINAL PLAT
Engineer C.G. KREBS

Engineer's Registration No. 773

File No. Drawing No.

Date 12, 1974 Scale 1" = 1320'

STATE OF WEST VIRGINIA
DEPARTMENT OF MINES
OIL AND GAS DIVISION
CHARLESTON

WELL LOCATION MAP
FILE NO. KAN-1443-A

NOW: 039 3680 REDRILL
+ Denotes location of well on United States
Topographic Maps, scale 1 to 62,500 lat-
itude and longitude lines being represented
by border lines as shown.

-- Denotes one inch spaces on border line
of original tracing.

47-039