

Latitude

38° 15'


2

3

25

8°

Longitude

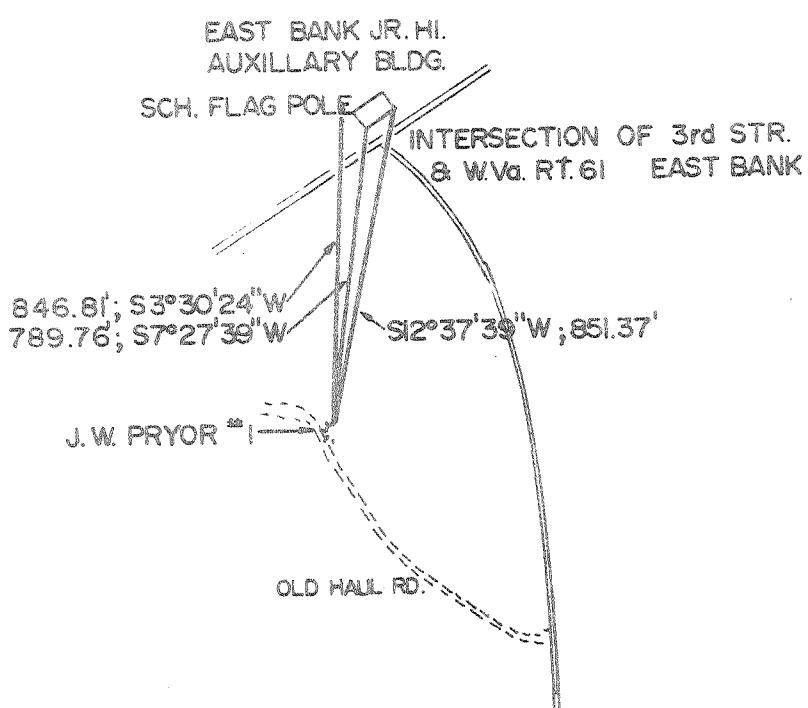

Topo Location

Richard D. Genthner

New Location  Minimum Error of Closure 1'-500'  
 Drill Deeper  Source of Elevation INTERSECTION OF 3rd STR. & U.S. RT. 60. GLASGOW, WV  
 Abandonment

"I, the undersigned, hereby certify that this map is correct to the best of my knowledge and belief and shows all the information required by paragraph 6 of the rules and regulations of the oil and gas section of the mining laws of West Virginia."

Company MILLS DRILLING CO. INC  
 Address 1402 E. LYNN RD. WAYNE WV 25570

Farm J. W. PRYOR

Tract \_\_\_\_\_ Acres \_\_\_\_\_ Lease No. \_\_\_\_\_

Well (Farm) No. 1 (One) Serial No. 361

Elevation (Spirit Level) 868.70' BM NW

Quadrangle CEDAR GROVE 7½ MONTGOMERY 15'  
 County KANAWHA District EAST BANK

Engineer RICHARD D. GENTHNER

Engineer's Registration No. PE-5862

File No. Drawing No. \_\_\_\_\_

Date 12-22-77 Scale 1"=500'

STATE OF WEST VIRGINIA  
 DEPARTMENT OF MINES  
 OIL AND GAS DIVISION  
 CHARLESTON

**WELL LOCATION MAP  
 FILE NO. KAN-1460-A**

\* Denotes location of well on United States Topographic Maps, scale 1 to 250,000 latitude and longitude lines being represented by border lines as shown.

- Denotes one inch spaces on border line of original tracing.

OCT 17 1978

47-039