


LATITUDE

38°30'

81°25'

LONGITUDE

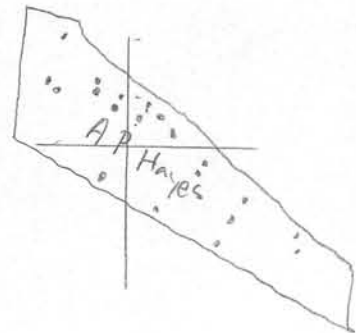

Approximate Location

7'5 OGIS topo location

7.5' loc _____ 15' loc _____
 _____ (calc.) _____

Company Preston Oil Co

Farm A. P. Hayes

Quad Blue Creek

County Kanawha

District Big Sandy

WELL LOCATION MAP

File No. 70036

Daugherty & Barth

70036

THE PRESTON OIL COMPANY

R. O. Daugherty, Superintendent, 1033 Quarrier St., Charleston I, West Virginia
Tel. -304-346-3648

Farm Name A. P. Hays Acreage 75
Township or District Big Sandy Sec., Lot or Mp. Sq. 72-65
County Kanawha State W. Va. Formation Big Lime Squaw
Oil Sold To Elk Refining Co. Gas Sold To -----
Royalty Interest (Oil) .125 (Gas) ----- Grade of Oil Eureka-Penna.

Production Record (Net Working Interest)

Oil (Bbls.)		Gas (MCF)	
1956	412	1961	-
1957	1035	1962	-
1958	85	1963	-
1959	-	1964	-
1960	-	1965	-

Material

	Well No. 2934		Well No.		Well No.		Well No.	
	Amount	Type	Amount	Type	Amount	Type	Amount	Type
13 3/8" Casing								
10 3/4" Casing	21							
8 5/8" Casing								
7" Casing	1505							
5 1/2" Casing								
4 1/2" Casing								
4" Liner								
4" Tubing								
3 1/2" Tubing								
2 3/8" Tubing	1775							
1 1/2" Tubing								
1" Tubing								
2" Line Pipe	1800							
3" Line Pipe								
Line Pipe (other)								
3/4" Sucker Rods								
5/8" Sucker Rods	1775							
Wire Pumping line								
Casing Packer	1	7 x 8						
Tubing Packer								
Subsurface Pump	1	W. B.						
Casing Head	1	7"						
Pumping Unit	1	None <i>good</i>						
Engine/Motor	1	None <i>No good</i>						
Standard Rig	60'	Pipe						
Cooling Tank								
Flow Tank (s)	1	30	<i>good</i>					
Stock Tank (s)	1	50	<i>good</i>					
Separator								
Heater-Treater								
Compressor								
Water Plant								
Electric Lines								
Shackle Lines								
Pumping Powers								
Misc. Equipment	Lot							

Also 1 - 20 HP J. C. Eng. *(Junk)*

Round Simpson post on location

The material inventory as shown hereon is taken from the records of The Preston Oil Company and is furnished to the prospective buyer for use as a guide in the submission of bids. The owner does not guarantee the amount, size or condition of materials listed.

*Rig need removing - ~~-----~~
- good prospect*

A. P. Hayes # 2934
Whit Record.

A. P. Hayes

<i>Date</i>	<i>Top</i>	<i>Bottom</i>
10-1-1912	1756	1766
9-7-1913	1755	1762
11-7-1913	1755	1760
6-1-1914	1755	1760
5-4-1915	1754	1760
9-30-1919	1754	1762
12-5-1927	1763	1785

