


LATITUDE 38°30'

LONGITUDE

81°25'

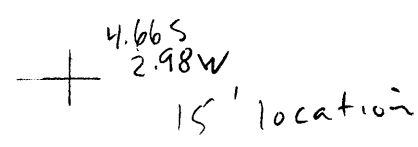

7.5 OGIS topo location

7.5' loc _____ 15' loc _____
 _____ (calc.) _____

Company South Penn Oil Co

Farm Jane O. Moles #1

Quad Clendenin 15'

County Kanawha

District EIK

WELL LOCATION MAP

File No. 039-70065

#155 in 1914 WVGES
Kanawha County Report

JANE O. MOLES NO. 1 WELL.

70065
1579
No.....on Map.

150

Elk District, Kanawha County, W. Va.
South Penn Oil Co.
1-3/4 mi. S. W. of Blue Creek P. O.; west edge of Blue Creek field.
Completed April 27, 1912.
Elevation, 1007' L.

#1500 Co RPT

	Top.	Bottom.
(Water at 700')		
Salt Sand (water at 1199'; hole fall, 1240')	1129	- 1601
Red rock	1637	- 1640
Lime	1640	- 1775
Slate	1775	- 1778
Little Lime	1778	- 1795
Pencil Cave	1795	- 1815
Big Lime	1815	- 1975
Slate and shells	1975	- 2071
Sand, Squaw (oil)	2071	- 2084