


LATITUDE

38° 30'

LONGITUDE 81° 25'

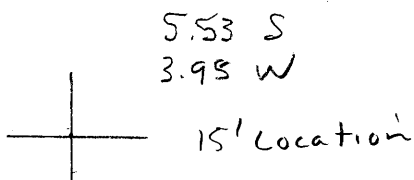

7.5 OGIS topo location

7.5' loc _____ 15' loc _____
 (calc.) _____

Company Grossep, Rumorel & Schuele Co

Farm D. J. Jarrett 5

Quad Clendwin 15'

County Kanawha

District E1K

WELL LOCATION MAP

File No. 40060 70116

#23 in 1914 WVGES

Kanawha County Report