


LATITUDE

38° 30'

LONGITUDE 81° 25'

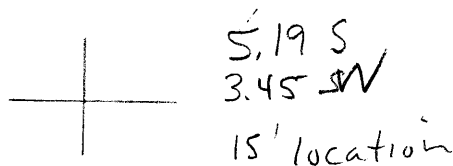

7.5 OGIS topo location

7.5' loc _____ 15' loc _____
 _____ (calc.) _____

Company Ohio Fuel

Farm J. F. Thumm 10

Quad Clendenin 15'

County Kanawha

District E1K

WELL LOCATION MAP

File No. 40140 70196

109 in 1914 WUGES

Kanawha County Report