


LATITUDE

38°30'

LONGITUDE 81°25'

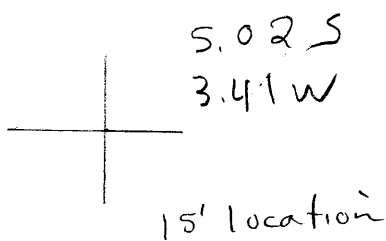

7'5 OGIS topo location

7.5' loc _____ 15' loc _____
 _____ (calc.) _____

Company Ohio Fuel

Farm SS Moore 6

Quad Clendenin 15'

County Kanawha

District E1K

WELL LOCATION MAP

File No. 40146 70202

#116 in 1914 WVGES
Kanawha county Report