


LATITUDE 38°30'

LONGITUDE 81°25'

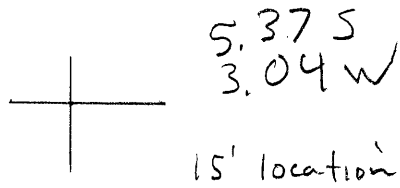

7.5 OGIS topo location

7.5' loc _____ 15' loc _____
 _____ (calc.) _____

Company United Fuel

Farm RA Wise 8

Quad Cleodonia 15'

County Kanawha

District E1K

WELL LOCATION MAP

File No. 40164 70220

137 in 1914 WGES
Kanawha County Report