


LATITUDE 38° 30'

LONGITUDE 01 25'

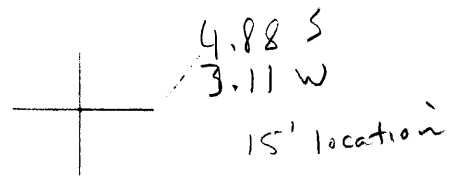

7'5 OGIS topo location

7.5' loc _____ 15' loc _____
 _____ (calc.) _____

Company South Penn

Farm Albert Myers 4

Quad Clendenin 15'

County Kanawha

District E1K

WELL LOCATION MAP

File No. 40180 70235

158 in Kanawha
1914 WV G&S County Report