


LATITUDE 38°30'

LONGITUDE 81°25'

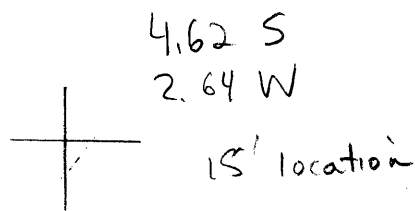

7'5 OGIS topo location

7.5' loc _____ 15' loc _____
 _____ (calc.) _____

Company Ohio Fuel

Farm G. W. White 10

Quad Clendenin 15'

County Kanawha

District EIK

WELL LOCATION MAP

File No. 40202 70257

#186 in Kanawha
1914 WV6ES County Report