


LATITUDE 38°30'

LONGITUDE 81°25'

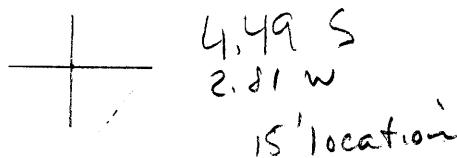

7'5 OGIS topo location

7.5' loc \_\_\_\_\_ 15' loc \_\_\_\_\_  
 \_\_\_\_\_ (calc.) \_\_\_\_\_

Company Ohio Fuel

Farm G. W. White 7

Quad Clendenin 15'

County Kanawha

District EIK

WELL LOCATION MAP

File No. 40205 70260

# 189 in Kanawha

1914 WV GCS County Report