


LATITUDE 38° 30'

LONGITUDE

81° 25'

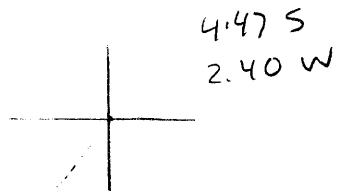

7.5 OGIS topo location

7.5' loc \_\_\_\_\_ 15' loc \_\_\_\_\_  
 \_\_\_\_\_ (calc.) \_\_\_\_\_

Company William S. Edwards Oil Co

Farm Graham Heirs 3

Quad Clendenin 15'

County Kanawha

District EIK

WELL LOCATION MAP

File No. 40219 70273

# 211 in Kanawha

1914 WVGES County Report