


LATITUDE

38° 30'

LONGITUDE

81° 25'

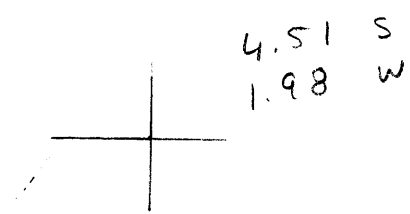

7'5 OGIS topo location

7.5' loc _____ 15' loc _____
 _____ (calc.) _____

Company United Fuel

Farm Keeton Heirs S

Quad Clendenin 15'

County Kanawha

District ELK

WELL LOCATION MAP

File No. 40224 70278

#216 in
1914 WVGES Kanawha county
Report