


LATITUDE 38° 30'

LONGITUDE 81° 25'

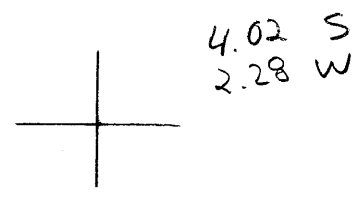

7'5 OGIS topo location

7.5' loc \_\_\_\_\_ 15' loc \_\_\_\_\_  
 \_\_\_\_\_ (calc.) \_\_\_\_\_

Company Ohio Fuel

Farm Schwartz & Barth 10

Quad Clendenin 15'

County Kanawha

District E1K

WELL LOCATION MAP

File No. 40239 70293

# 231 in Kanawha

1914 WVGES County Report