


LATITUDE 38° 30'

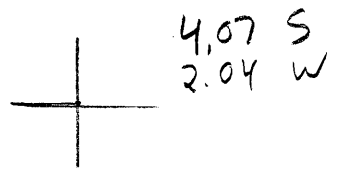

LONGITUDE 81° 25'

7.5 OGIS topo location

7.5' loc _____ 15' loc _____
 _____ (calc.) _____

Company Davidson & Gates
 Farm Davidson & Gates 6
 Quad Clendenin 15'
 County Kanawha
 District ELK

WELL LOCATION MAP
 File No. 40242 70296
 #234 in Kanawha
 1914 WVGES County Report