


LATITUDE 38° 30'

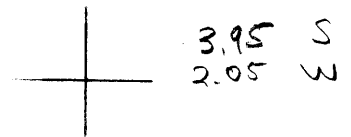

LONGITUDE 81° 25'

7'5 OGIS topo location

7.5' loc _____ 15' loc _____
 _____ (calc.) _____

Company Ohio Fuel

Farm B. Price 1

Quad Clendenin 15'

County Kanawha

District ELK

WELL LOCATION MAP

File No. 40244 70298

236 in 1914 WVGES
Kanawha County
Report