


LATITUDE 38°30'

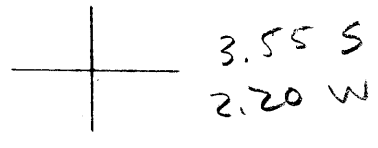

LONGITUDE 81°25'

7'5 OGIS topo location

7.5' loc _____ 15' loc _____
 _____ (calc.) _____

Company William S. Edwards Oil Co

Farm Kanawha & WVA. 6

Quad Clendenin 15'

County Kanawha

District EIK

WELL LOCATION MAP

File No. 40248 70302

241 in Kanawha

1914 WVA 6ES County Report