


LATITUDE 38° 30'

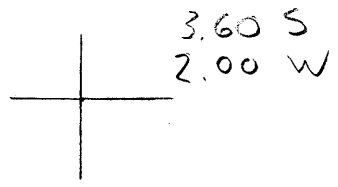

LONGITUDE 81° 25'

7'5 OGIS topo location

7.5' loc \_\_\_\_\_ 15' loc \_\_\_\_\_  
 \_\_\_\_\_ (calc.) \_\_\_\_\_

Company Steinbeck & Kirtley

Farm Steinbeck 1

Quad Clendenin 15'

County Kanawha

District EIK

WELL LOCATION MAP

File No. 40252 70306

# 245 in Kanawha

1914 WUGES County Report