7'5 OGIS topo location

7.5' loc 2395

Company


Farm \_\_\_\_

Quad BERLIN 7/2: County LEWIS

District HACKERS CREEK

WELL LOCATION MAP

File No. 041-651A

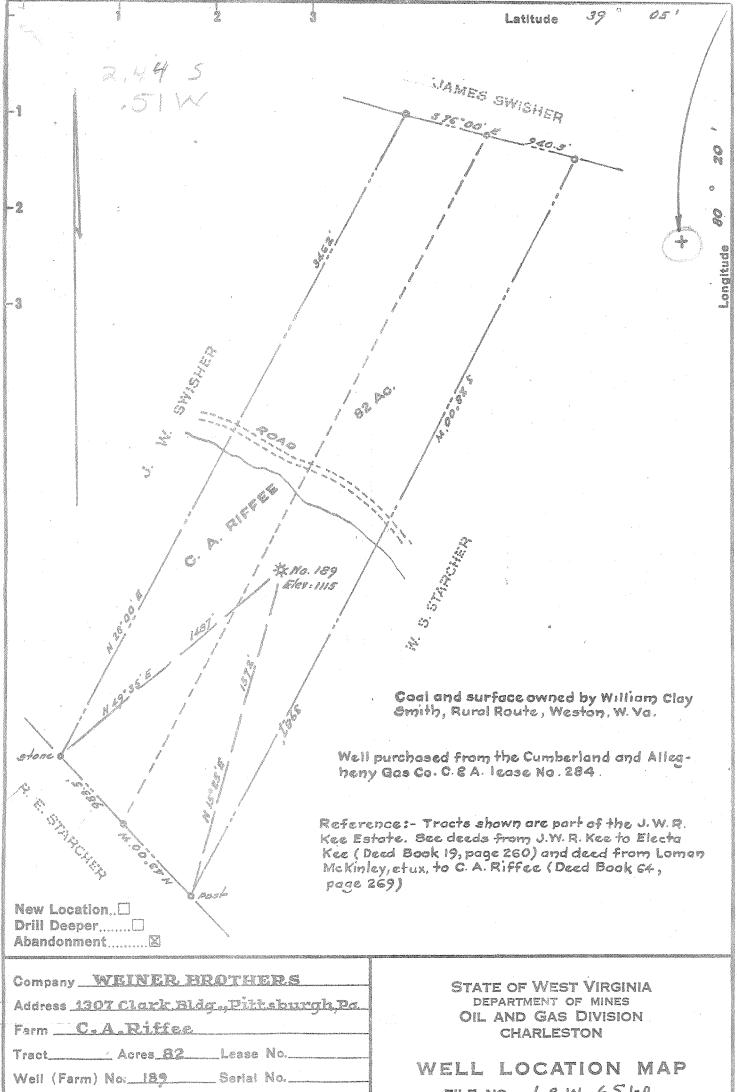

Quadrangle <u>Westox</u> County LEWIS \_District <u>Hackers Cr</u> Engineer's Registration No. . \_\_Drawing No. . Scale: 1": 500" Date October, 1955

## FILE NO. LEW-651-A

- 4 Denotes location of well on United States Topographic Maps, scale 1 to 62,500, latitude and longitude lines being represented by border lines as shown.
- Denotes one inch spaces on border line of original tracing.



DEPARTMENT OF MINES Formerly: Bastern Oil Company

Quadrangle		<del>y'</del>	on the an increased the en					
Permit No	La Company of the Com		WELL	RECORE	)	Oil or G	as Well_	
W.S.	sing <del>a Jacob</del>	<del>are (Year 44</del> 4	<del>1112</del>	HH-Contrology Control				(KIND)
Company			·	Casing and	Used in	Left in		
A 11		, & Cwishor		Tubing	Drilling	Well		Packers
1,7 (		3 % 0.002.01402	Salah Salah Salah Salah				-	
			Acres	Size	9			
Well No	39 (2)		Files / Junes.	16			Kind of	Packer
	Chers Crk.	County	#187/	13		201		<del>6-5/8 x 2</del>
		•		10	***************************************	Dalla.	Size of	
		· ·		j		six descriptions on sixtee		20201
			Alway	81/4		1/2/		
viinerai rights ai		and the second second		6%			_ Depth s	et
	July	Address		5 3/16		# 2 A 2 A	-	
Orilling commend	ced	<del>andar 11, 19</del> ,	4	3		<u> </u>	1 *	p
			2324*	2		·		ttom
				Liners Used			Perf. to	0
							į.	ttom
			Inch			***************************************		
			Inch	CASING CEME	ENTEDS	SIZE	No. Ft	Date
Volume			Cu. Ft.					
		lbs			Y C C C T T T T T T T T T T T T T T T T	4 770	Y2 72 72 72 72 72 72 72 72 72 72 72 72 72	DETTOTES
)il			_bbls., 1st 24 hrs.	CUAL WAS EI	NCOUNTERED .	AT	rreer	INCHES
resh water		feet	feet	FEET	INCH	ES	FEET	INCHES
alt water		feet	feet	FEE1	INCH	ES	FEET	INCHES
Formation	Color	Hard or Soft	Тор	Bottom	Oil, Gas or Water	Depth Found		Remarks
Slate	hos II c			J. Gar. 35	- 10 Wax 2t	St. Tourid		
idtilo V			325	375				
late	i.		375	120				
Big Dunka			410	<u>L70</u>		4.5		
Slate A	nells		1:70	500	had you be no made on the	6301		
Ses Send	1 1 1 1 1 1 1 1 1 1 1 1 1 1 1 1 1 1 1		500	690	water at	Salar Car		
Slate			690	73.0	water at	795.1		
lst selt Slata			786	8.0	the state of the s			
SANTANIAN TANKS THE SECOND	Parameter dispute that	, ,	2. 450 sate.			F -		

Salt water		feet		FEET	INCH	ESFEE	rinches
Formation	Color	Hard or Soft	Тор	Bottom	Oil, Gas or Water	Depth Found	Remarks
Slate	1			345			egy (gygy), gyn hyny yn hyd yn ddirmadd y gyg hann y gyn y fydd yr hann had daeth y ferio ddireithiol y canal tha ddireithiol y gyn
Little D			325	375			
Slate			375	110			
Mig Tunka			110	<u>ls70</u>		L A A	
Slate &	parra		l:70	500	53 a. A	6202	
Cas Sand			500	690	water at	Salaria "	
Slate	1		690	73.9	the same of the		
lst Selt			710	7.9.6	water at	142	
Slate			736	340	5.60	n n winter to the	A Theorem and the Second
2mi Salt	Sand		840	1210	Macer av		ilors pr. hr.
Red Rock			7570	3102			
Little L			1.05	7/52			
Pencil D	170		2425	1435			
Mig Lime			2435	1510			<i>1</i> <sup>∞</sup> /11/2 <b>8</b>
Min inju	<b>1</b>		3,510	242	STALL GIR	unt of ses 1	
Slate			1642	2628		-	
cuav			<b>16</b> 18	1725		Control of the Contro	
Slate 4	holls		1.725	1,390			
iants			1390	1930	A CONTRACTOR OF THE PARTY OF TH		
Slate			1930	1935			
Fifty Fo		To the state of th	1935	2002	2000		
·Inirty S			2005	2030	and the same of th		
Slate	Phells		2030	2311			
TAPUL Sa	nd ·		231.	2330	080 Z313	to 2325	· · · · · · · · · · · · · · · · · · ·
Total Ce	***			2383	Well sho	t with 20 qt	siell 3 x 10
We also an effection in self-	Sec. allumine				top of s	iot 2314' -	xo tom <b>232</b> 4
Î			500		lest bef	ore shot 3/1	111-2" 1191465
		15864		The second secon	lest aft	er shot 25/1	1 W - 2" 211 Mct
		/8% - 0s	010- 30	***			
		Na Alaman	1955 Q	6000miaan			
		REOR	(VER 3)	Li Cultado Jun			
			remark of				
-		or or					
		1 Y0.	7774				
1		1 Section 1	_ 12 3 224 56	1	1	1	