


Latitude 39 35

Longitude 80 15

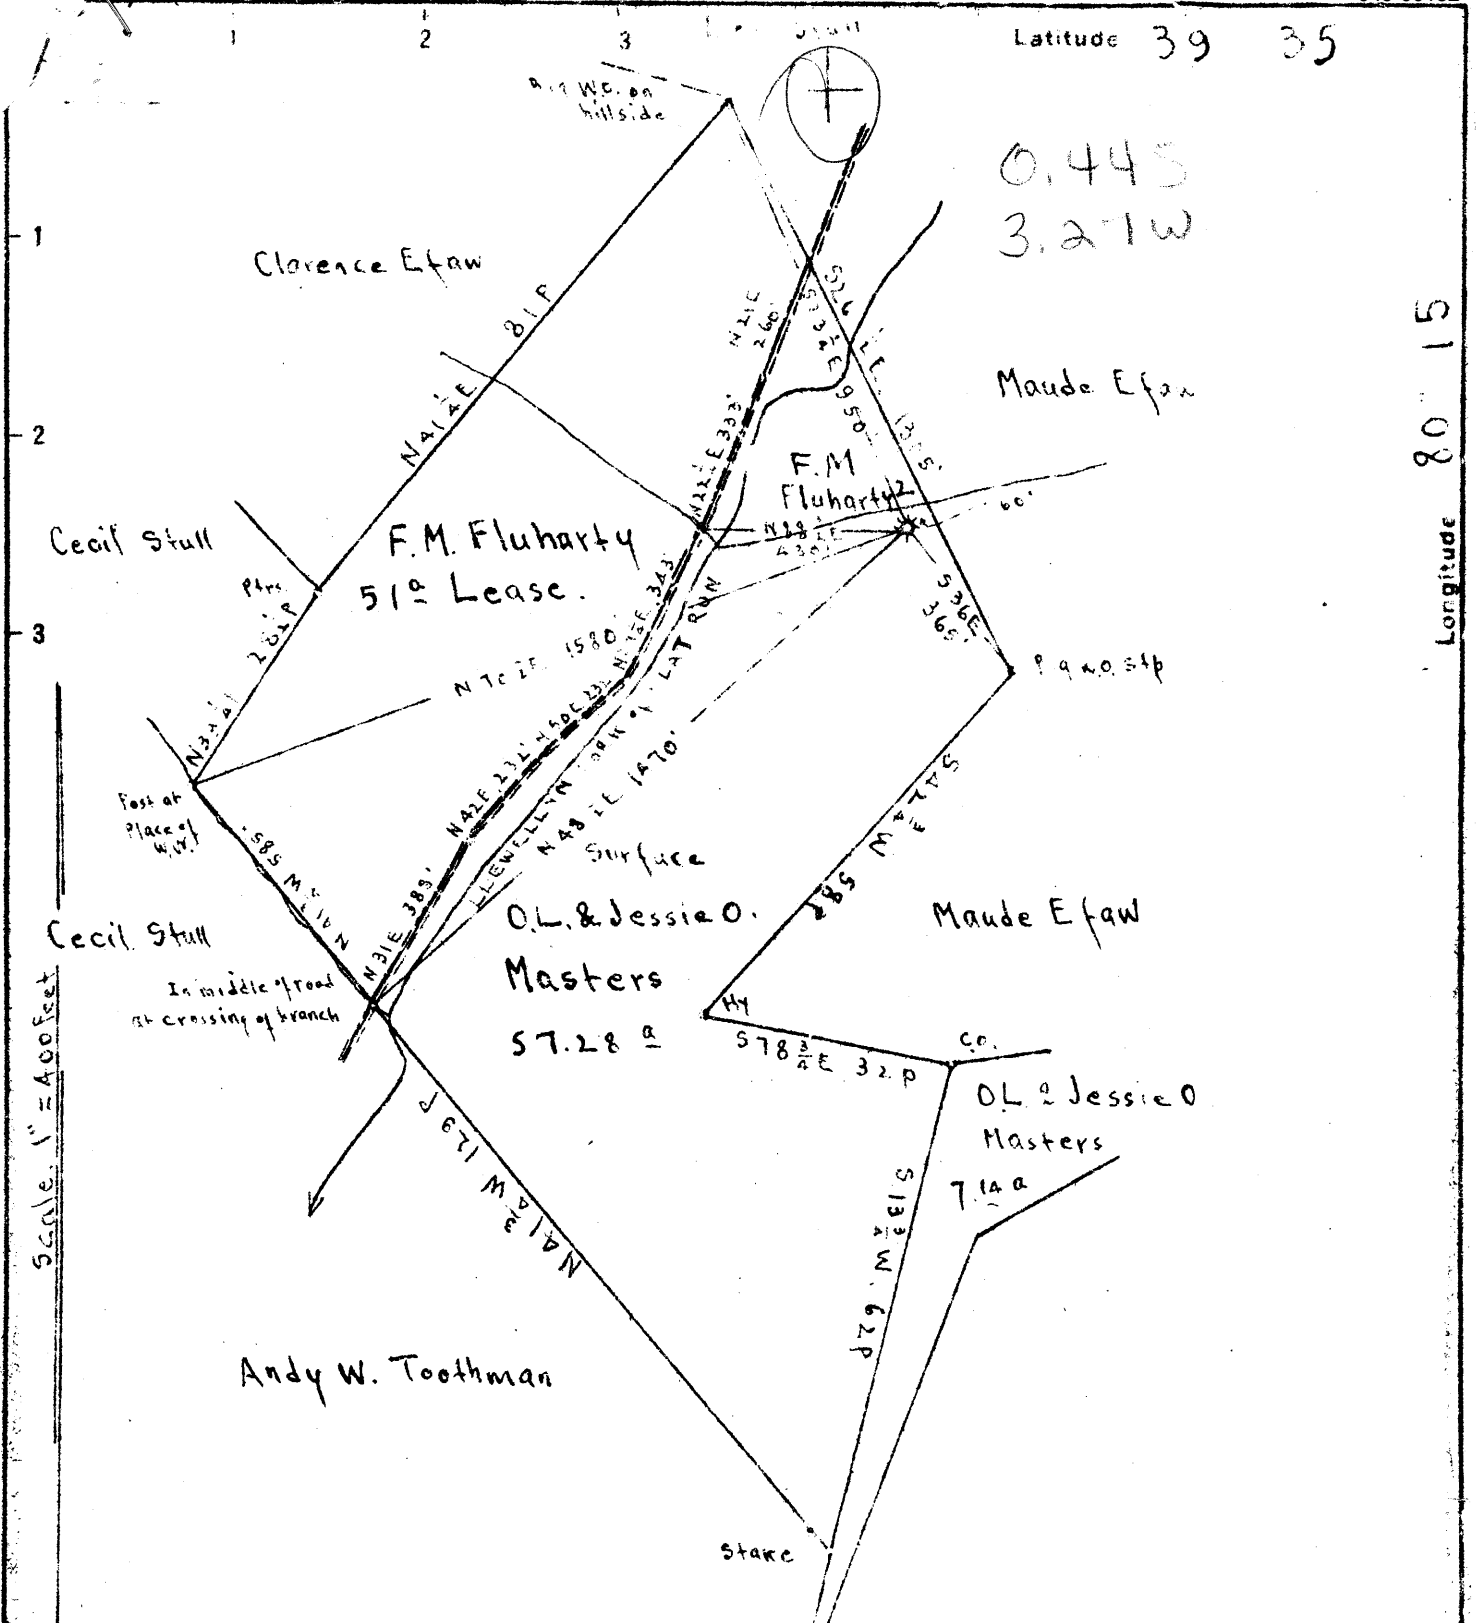

0.445
3.27W

Scale 1" = 400 Feet

Surface: O.L. & Jessie O. Masters.
R.F.D. #3, Mannington, W.Va.

DTT

Pittsburgh Coal: Wheeling Dollar Springs & Trust Co., Wheeling, W.Va.

New Location
Drill Deeper
Abandonment

On AOC Map 2658 N 9 E 17-18

Company Byron L. Hall
 Address R.F.D. #3 Mannington, W.Va.
 Farm F.M. Fluharty
 Tract _____ Acres 51 Lease No. _____
 Well (Farm) No. 2 Serial No. _____
 Elevation (Spirit Level) Floor - 1158.16
Ground - 1156.40
 Quadrangle MANNINGTON
 County Marion District Mannington
 Engineer E.C. Tabler
 Engineer's Registration No. _____
 File No. _____ Drawing No. _____
 Date Feb. 20th 1948 Scale 1" = 400 Feet

STATE OF WEST VIRGINIA
DEPARTMENT OF MINES
OIL AND GAS DIVISION
CHARLESTON

WELL LOCATION MAP
FILE NO. MAR-192D

+ Denotes location of well on United States Topographic Maps, scale 1 to 62,500. Latitude and longitude lines being represented by border lines as shown.

- Denotes one inch spaces on border line of original tracing.

WEST VIRGINIA DEPARTMENT OF MINES
OIL & GAS DIVISION
W E L L R E C O R D

Permit No.	Mar 182 D	Dry Well		
Mannington Quad.		CASING & TUBING		
Company	Byron L. Hall			
Address	Route 3, Mannington, W.Va.	10	160	160
Farm	F.M. Fluaharty Acres 51	8 $\frac{1}{2}$	1190	1190
Location	Llewellyn	6 $\frac{5}{8}$	1660	1660
Well No.	2	Elev. F 1158.10	5 $\frac{3}{16}$	2035 2035
		G 1156.40	Liners used	813 813
District	Mannington Marion County			
Surface	O.L. and Jessie O. Masters			
	Mannington, W.Va.			
Mineral	G.L. Fluaharty Agt, Mannington, W.Va.			
	Byron Hall , "			
	Andrew W. Morrison, Eighty-four, Pa.			
Commenced	May 3, 1948			
Completed	June 8, 1948			
Open flow	10/10ths W in 1"			
Fresh Water	None			

STARTED DRILLING DEEPER AT THE FOLLOWING FORMATION

Sand	Wh	H	2978	2987	Gas 3070-3073 Light		
Slate	Gr	S	2987	2989	Gas 3111-3113 Blew out		
Lime	Wh	H	2989	2990	Gas 3116-3118 Blew out		
Sand	Wh	H	2990	2997	Oil and gas 3762-3763 showing		
Slate & Shells	Gr	H&S	2997	3070	Gas 3980-3981 showing		
5th Sand	Wh	S	3070	3075			
Slate	Gr	S	3075	3077			
Lime	Wh	H	3077	3086	THE FOLLOWING IS THE RECORD I WAS		
Slate & Shells	Gr	M	3086	3108	GIVEN WHEN I PURCHASED WELL		
Byard	Dk	S	3108	3113			
Slate	Gr	S	3113	3116	Phg. coal	690	690
2nd Byard	Dk	S	3116	3129	Big Injun	2000	2140
Slate & Shells	M		3129	3170	Fifty Foot	2605	2655
Lime	Wh	H	3170	3186	Gordon	2880	2895
Slate	Gr	S	3186	3225	Fourth Sand	2925	2947
Gritty Lime	Wh	H	3225	3240	Total Depth		2978
Slate	Gr	S	3240	3248			
Gritty Lime	Wh	H	3248	3282	Gas 2005 show		
Slate	Gr	S	3282	3292	Oil and Water 2100 show		
Gritty Lime	Wh	H	3292	3302	Gas 2927-2932		
Slate	Gr	S	3302	3460			
Gritty Lime	Wh	H	3460	3480			
Slate	Gr	S	3480	3506			
Gritty Lime	Wh	H	3506	3530			
Slate	Gr	S	3530	3542			
Gritty Lime	Wh	H	3542	3562			
Slate	Gr	S	3562	3572			
Gritty Lime	Wh	H	3572	3612			
Slate	Gr	S	3612	3653			
Gritty Lime	Wh	H	3653	3690			
Slate	Gr	S	3690	3696			
Gritty Lime	Wh	H	3696	3716			
Slate & Shells	Gr	M	3716	3756			
Gritty Lime	Wh	H	3756	3764			
Lime	Wh	H	3764	3768			
Slate	Gr	S	3768	3781			
Gritty Lime	Wh	H	3781	3796			
Slate	Gr	S	3796	3820			
Gritty Lime	Wh	H	3820	3845			
Slate	Gr	S	3845	3885			
Lime Shells	Wh	M	3885	3907			
Gritty Lime	Wh	H	3907	3913			
Slate & Shells	Gr	S	3913	3970			
Lime	Wh	H	3970	3980			
Slate	Gr	S	3980	3985			
Gritty Lime	Wh	H	3985	4004			
Slate & Shells	Gr	S	4004	4070			
Gritty Lime	Wh	H	4070	4155			
Slate	Gr	S	4155	4225	T.D.		