

STATE OF WEST VIRGINIA
DEPARTMENT OF ENVIRONMENTAL PROTECTION
OFFICE OF OIL AND GAS

AFFIDAVIT OF PLUGGING AND FILLING WELL

AFFIDAVIT SHOULD BE IN TRIPLICATED, one copy mailed to the Department, one copy to be retained by the Well Operator and the third copy (and extra copies if required) should be mailed to each coal operator at their respective addresses.

Farm name: John Lawlis Etux Operator Well No.: WV 606188

LOCATION: Elevation: 1012' Quadrangle: 7.5' Glover Gap
District: Mannington County: Marion
Latitude: 0 Feet South of 39 Deg. 31 Min. 4.9512 Sec.
Longitude: 0 Feet West of 80 Deg. 26 Min. 24.9714 Sec.

Well Type: OIL GAS

Company Equitrans, LP Coal Operator Murray Energy Corporation
625 Liberty Ave or Owner 46226 National Road
Pittsburgh, PA 15222 St. Clairsville, OH 43950
Agent Justin Macken Coal Operator _____
Permit Issued Date 7/19/2016 or Owner _____

AFFIDAVIT

STATE OF WEST VIRGINIA,
County of Marion ss:

Brian A. Hall and Mike Boggs being first duly sworn according to law depose and say that they are experienced in the work of plugging and filling oil and gas wells and were employed by the above named well operator, and participated in the work of plugging and filling the above well say that said work was commenced on the 5h day of August, 2016, and the well was plugged and filled in the following manner:

TYPE	FROM	TO	PIPE REMOVED	LEFT
Class A cement	2047'	1976'	2003' of 5.5"	0'
Class A cement	1976'	569'	0'	1990' of 7" and 1301' of 8-5/8"
Class A cement	569'	surface	0'	226' of 10-3/4"


RECEIVED
Office of Oil and Gas
MAY 10 2018
WV Department of Environmental Protection

Description of monument: 32' of 5.5" with API # & date plugged and that the work of plugging and filling said well was completed on the 22nd day of August, 2016.

And further deponents saith not. Brian A. Hall
Mike Boggs

Sworn and subscribe before me this 8th day of February, 2018.

My commission expires: April 9 2022
Jeffery L Wright
Notary Public

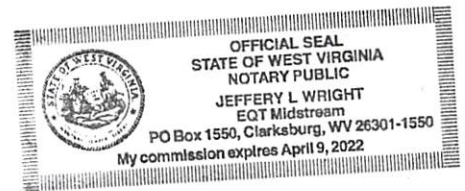


Affidavit reviewed by the Office of Oil and Gas: S J D Wainwright Title: COG Inspector

Well 6188 (I/W)

Well Name: J. Lawlis
 API No.: 47-049-00224
 Lease No.: 24832
 Location: Mannington Dist., Marion Co.
 Drilled: 8/31/18, TD @ 2040'
 Drilled Deeper: 5/3/22, D/D TD 3194'
 Storage: 8/1/51
 Repaired & CO: 8/10/1951 COTD 2122'
 PBD 2076'
 Repaired & CO: 5/3/1954 COTD 2082'
 PBD 2047'

* Presumed weights - exact weight unknown!

Logansport Storage Field

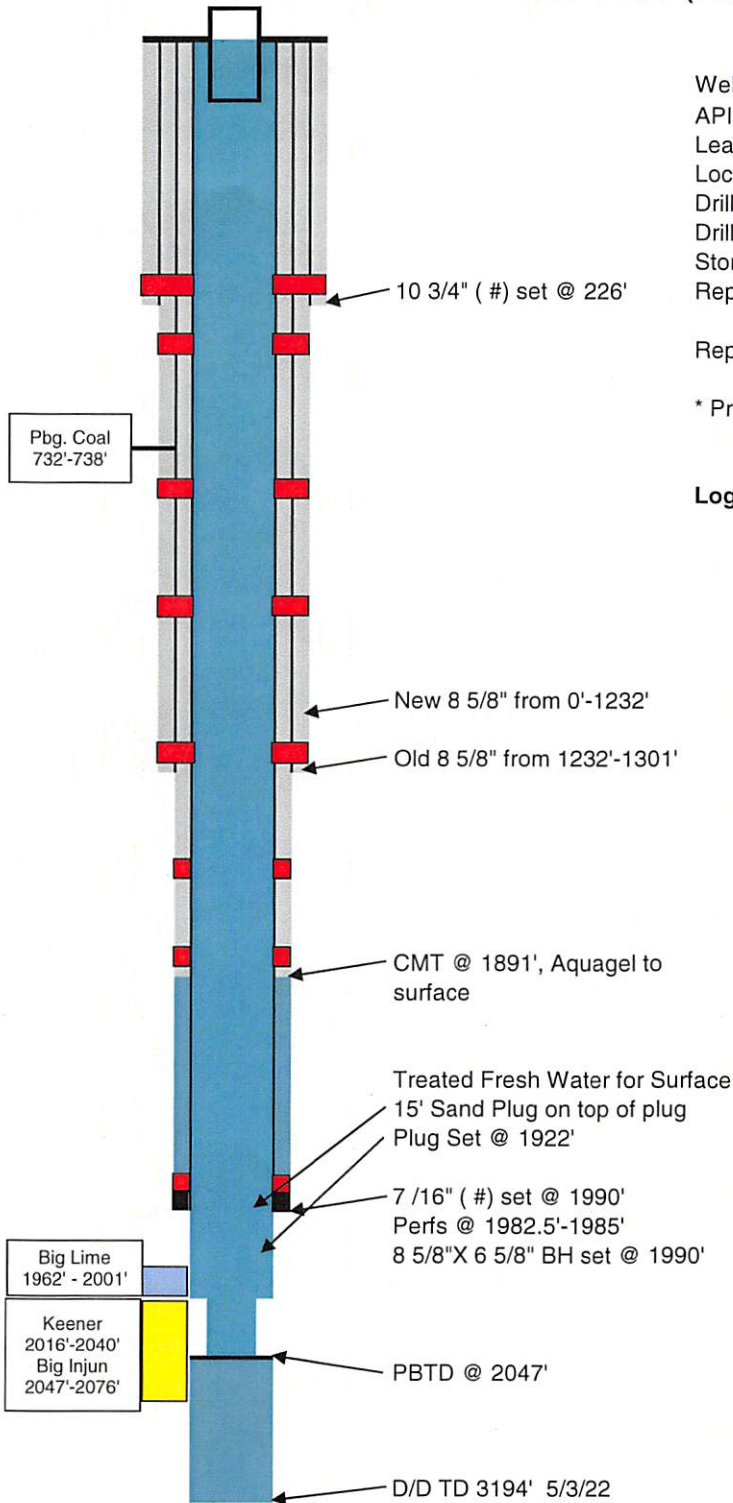

- Packer
- Perforations
- Cement
- Squeezed Cement

RECEIVED
 Office of Oil and Gas
 MAY 10 2018
 WV Department of
 Environmental Protection