

LATITUDE 39° 37' 30"

80° 20' 00"

LONGITUDE



7'5 OGIS topo location

7.5' loc 0.935 15' loc _____
 2.03 W (calc.) _____

Company _____

Farm _____

Quad MANNINGTON 7 1/2'


County MARION

District MANNINGTON

Ele. 1395± (topo)

WELL LOCATION MAP

File No. 049-0551

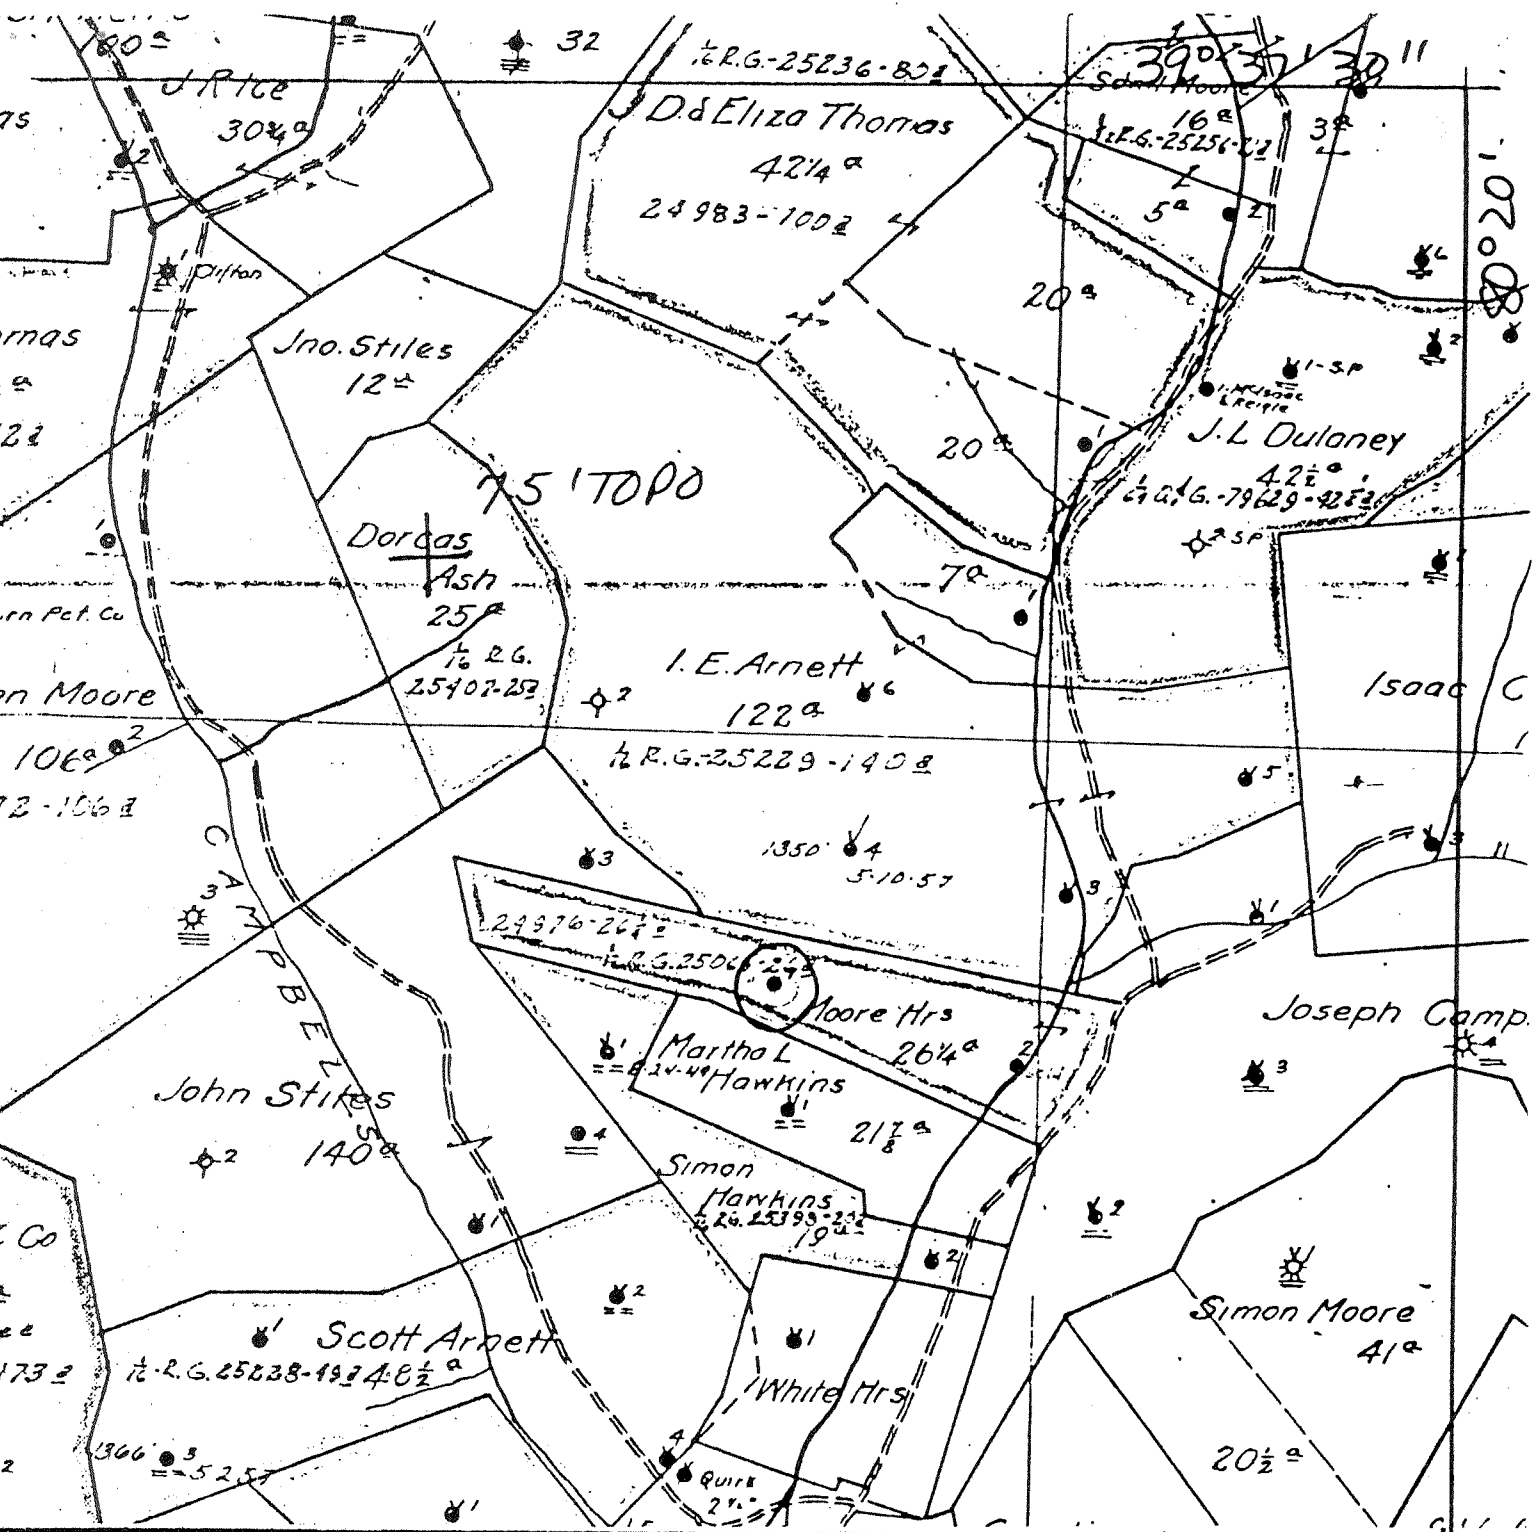

FILE NO. _____
 DRAWING NO. _____
 SCALE _____
 MINIMUM DEGREE OF ACCURACY _____
 PROVIN SOURCE OF ELEVATION _____

I THE UNDERSIGNED, HEREBY CERTIFY THAT THIS PLAT IS CORRECT TO THE BEST OF MY KNOWLEDGE AND BELIEF AND SHOWS ALL THE INFORMATION REQUIRED BY LAW AND THE REGULATIONS ISSUED AND PRESCRIBED BY THE DEPARTMENT OF MINES.
 (SIGNED) _____
 R.P.E. _____ L.L.S. _____

PLACE SEAL HERE

) DENOTES LOCATION OF WELL ON UNITED STATES TOPOGRAPHIC MAPS
 FORM IV-6
 10-79



DATE 8-27, 1980
 OPERATOR'S WELL NO. 1
 API WELL NO. 47-049-0551
 STATE COUNTY PERMIT

STATE OF WEST VIRGINIA
 DEPARTMENT OF MINES
 OIL AND GAS DIVISION

WELL TYPE: OIL GAS _____ LIQUID INJECTION _____ WASTE DISPOSAL _____
 (IF "GAS", PRODUCTION _____ STORAGE _____ DEEP _____ SHALLOW
 LOCATION: ELEVATION _____ WATER SHED Campbell Run
 DISTRICT MANNINGTON COUNTY MARION
 QUADRANGLE MANNINGTON 75'

SURFACE OWNER _____ ACREAGE _____
 OIL & GAS ROYALTY OWNER _____ LEASE ACREAGE _____
 LEASE NO. _____
 PROPOSED WORK: DRILL _____ CONVERT _____ DRILL DEEPER _____ REDRILL _____ FRACTURE OR STIMULATE _____ PLUS OFF OLD FORMATION _____ PERFORATE NEW FORMATION _____ OTHER PHYSICAL CHANGE IN WELL (SPECIFY) _____

PLUG AND ABANDON _____ CLEAN OUT AND REPLUG _____
 TARGET FORMATION _____ ESTIMATED DEPTH _____
 WELL OPERATOR PENNZOIL COMPANY DESIGNATED AGENT JAMES A CREWS
 ADDRESS P. O. DRAWER 1588 ADDRESS PENNZOIL COMPANY
PARKERSBURG, W. VA. 26101 P. O. DRAWER 1588

SOUTH PENN OIL COMPANY—COMPLETION

WELL NO. 1
 FARM E. Moore Heirs
 SECTION 11 S. 15 W.
 ACRES _____
 CAMPBELLS RUN PYLES FORK OF BUFFALO CREEK
 DISTRICT Mannington COUNTY Marion STATE W. Va.
 DRILLING COMMENCED AUG. 10, 1897 COMPLETED NOV. 3, 1897 DEPTH 3340

SANDS	TOP	BOTTOM	ELEV. TOP	CASING
COAL OR LIMESTONE	1175	1185		10" 239'
Bankard	1670	1750		8" 1662'
g Lime	2455	2520		6-5/8" 2434'
g Injun	2520	2660		5-3/16" 2532'
ity Foot	3150	3180		4-1/4" 303'
ray	3312	3322		PACKERS AND DEPTH SET
rdon	3330			

SAND Gordon DEPTH 3331 & 3340
 TEST " "

T. Feb. 28, 1900 QUARTS 30 " Gordon " 3331

MARKS _____
 REPORTED BY METZ DISTRICT. ABANDONED _____

5-5-43 3097 open shot Gordon TOP 3330
 3340

Sorry Original

47-049-0551