

WW-7  
8-30-06



West Virginia Department of Environmental Protection  
Office of Oil and Gas  
**WELL LOCATION FORM: GPS**

API: 47-049-00970 WELL NO.: 1  
FARM NAME: DeFazio, Joe  
RESPONSIBLE PARTY NAME: XTO Energy INC.  
COUNTY: Marion DISTRICT: Grant  
QUADRANGLE: Fairmont West, WV  
SURFACE OWNER: Joseph A DeFazio Living Trust  
ROYALTY OWNER: CLARENCE MUTSCHIELKNAUS  
UTM GPS NORTHING: 4366701.5 Meters  
UTM GPS EASTING: 568543.8 Meters GPS ELEVATION: 999.6 Ft

The Responsible Party named above has chosen to submit GPS coordinates in lieu of preparing a new well location plat for a plugging permit or assigned API number on the above well. The Office of Oil and Gas will not accept GPS coordinates that do not meet the following requirements:

- 1. Datum: NAD 1983, Zone: 17 North, Coordinate Units: meters, Altitude: height above mean sea level (MSL) – meters.
- 2. Accuracy to Datum – 3.05 meters
- 3. Data Collection Method:

Survey grade GPS : Post Processed Differential   
Real-Time Differential

Mapping Grade GPS : Post Processed Differential   
Real-Time Differential


- 4. Letter size copy of the topography map showing the well location.

I the undersigned, hereby certify this data is correct to the best of my knowledge and belief and shows all the information required by law and the regulations issued and prescribed by the Office of Oil and Gas.

[Signature] Project Manager 11-8-17  
Signature Title Date

RECEIVED  
Office of Oil and Gas

NOV 14 2017

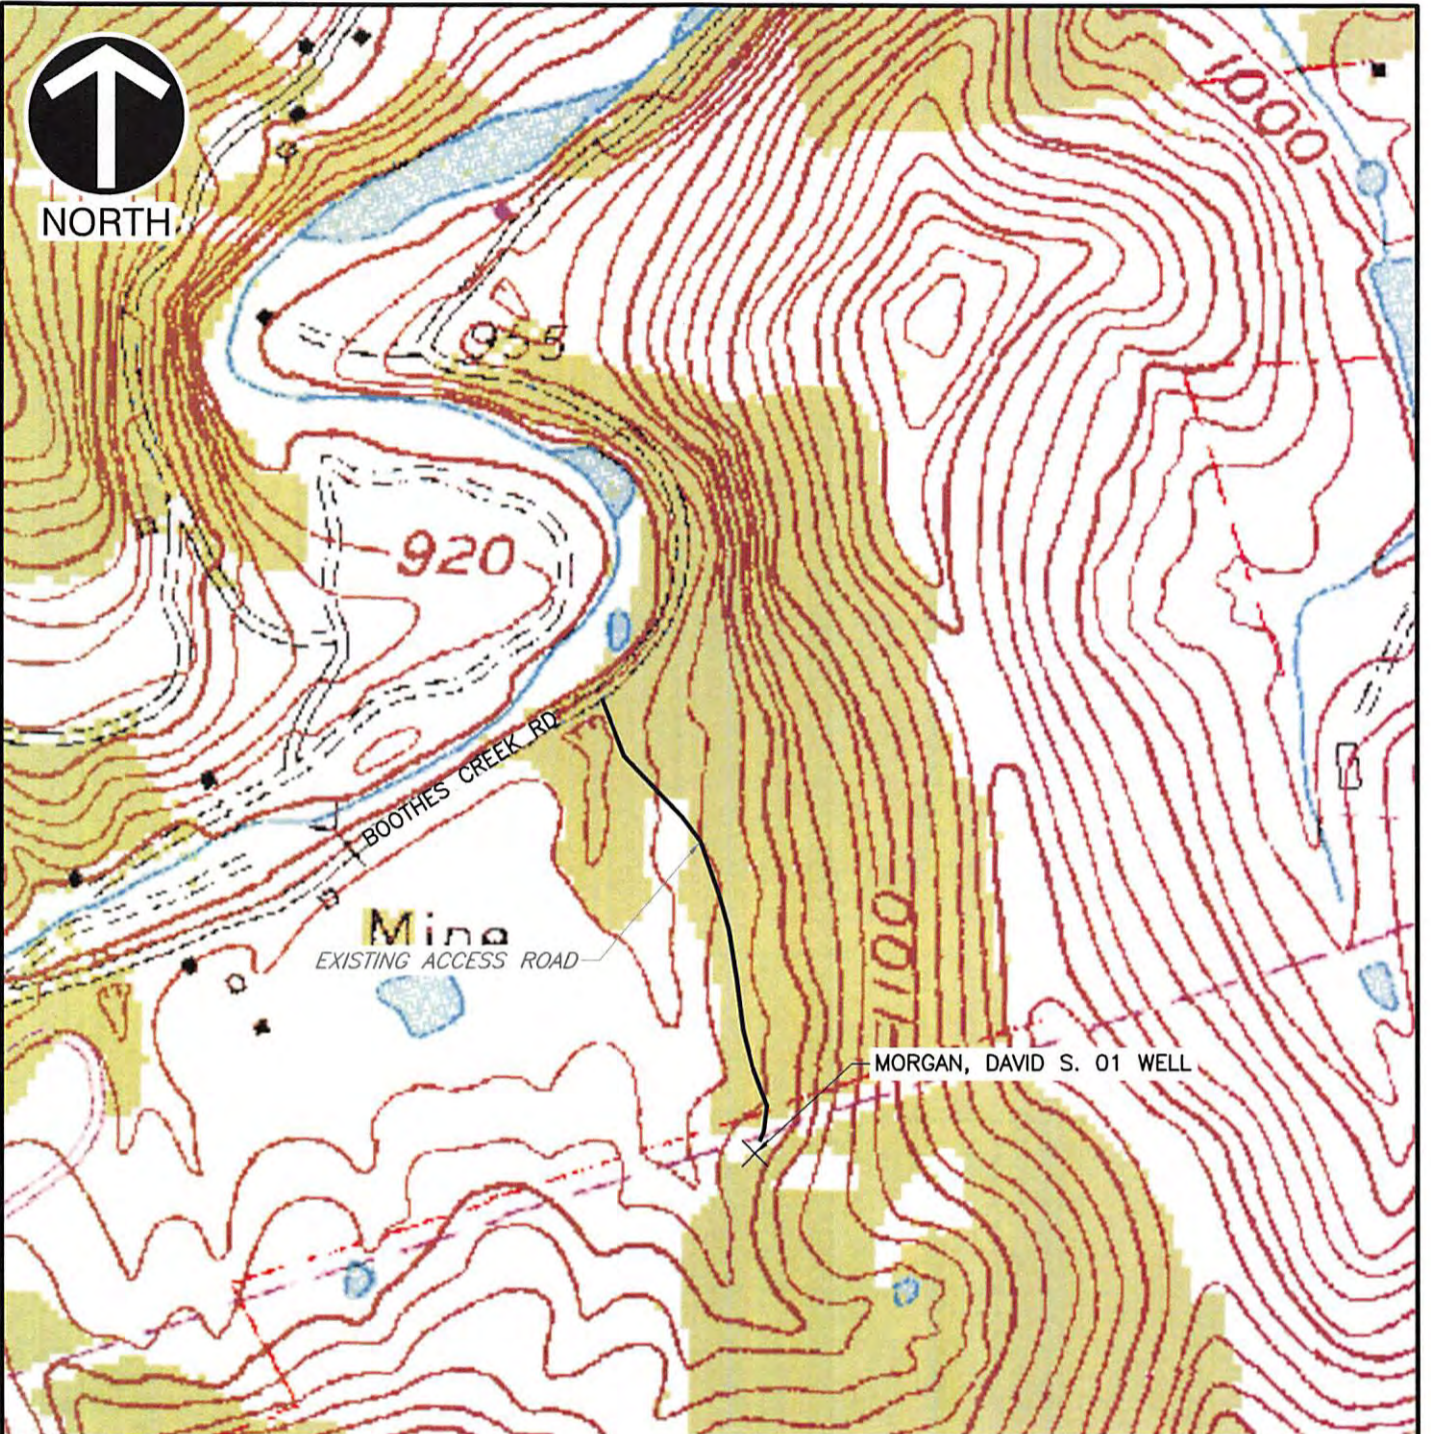

**REFERENCE**

1. U.S.G.S. 7.5' TOPOGRAPHIC MAP, FAIRMONT WEST QUADRANGLE, WEST VIRGINIA DATED: 1955



**Civil & Environmental Consultants, Inc.**

333 Baldwin Road · Pittsburgh, PA 15205  
412-429-2324 · 800-365-2324

www.cecinc.com \* HAND SIGNATURE ON FILE

XTO ENERGY, INC.  
MORGAN, DAVID S. 01  
WELL PLUG  
MARION COUNTY, WEST VIRGINIA

**SITE LOCATION MAP**

DRAWN BY:	TLW	CHECKED BY:	EAH	APPROVED BY:	BCL*	FIGURE NO.:	1
DATE:	9-28-17	DWG SCALE:	1"=500'	PROJECT NO:	174-307		12/15/2017

RECEIVED  
Office of Oil and Gas

NOV - 6 2017

WV Department of  
Environmental Protection

P:\2017\174-307\CADD\DWG\CADD\CV01\174-307-CV01-SiteLocationMap.dwg(LAYOUT) LS:(9/28/2017 - tweaver) - LP: 9/28/2017 12:35 PM