

WW-7
8-30-06



West Virginia Department of Environmental Protection
Office of Oil and Gas

WELL LOCATION FORM: GPS

API: 47-049-01343 WELL NO.: E-510R
 FARM NAME: Canjar
 RESPONSIBLE PARTY NAME: XTO Energy, Inc.
 COUNTY: Marion DISTRICT: Lincoln
 QUADRANGLE: Shinnston
 SURFACE OWNER: John P. Canjar
 ROYALTY OWNER: See attached list
 UTM GPS NORTHING: 4370115.5
 UTM GPS EASTING: 559014.9 GPS ELEVATION: 359 meters (1178')

The Responsible Party named above has chosen to submit GPS coordinates in lieu of preparing a new well location plat for a plugging permit or assigned API number on the above well. The Office of Oil and Gas will not accept GPS coordinates that do not meet the following requirements:

1. Datum: NAD 1983, Zone: 17 North, Coordinate Units: meters, Altitude: height above mean sea level (MSL) – meters.

2. Accuracy to Datum – 3.05 meters

3. Data Collection Method:

Survey grade GPS : Post Processed Differential

Real-Time Differential

Mapping Grade GPS : Post Processed Differential

Real-Time Differential

4. Letter size copy of the topography map showing the well location.

I the undersigned, hereby certify this data is correct to the best of my knowledge and belief and shows all the information required by law and the regulations issued and prescribed by the Office of Oil and Gas.

Signature


Valley
Project Manager

Title

June 19, 2015

Date

received
Office of Oil & Gas
08/07/2015
JUL 2 2015

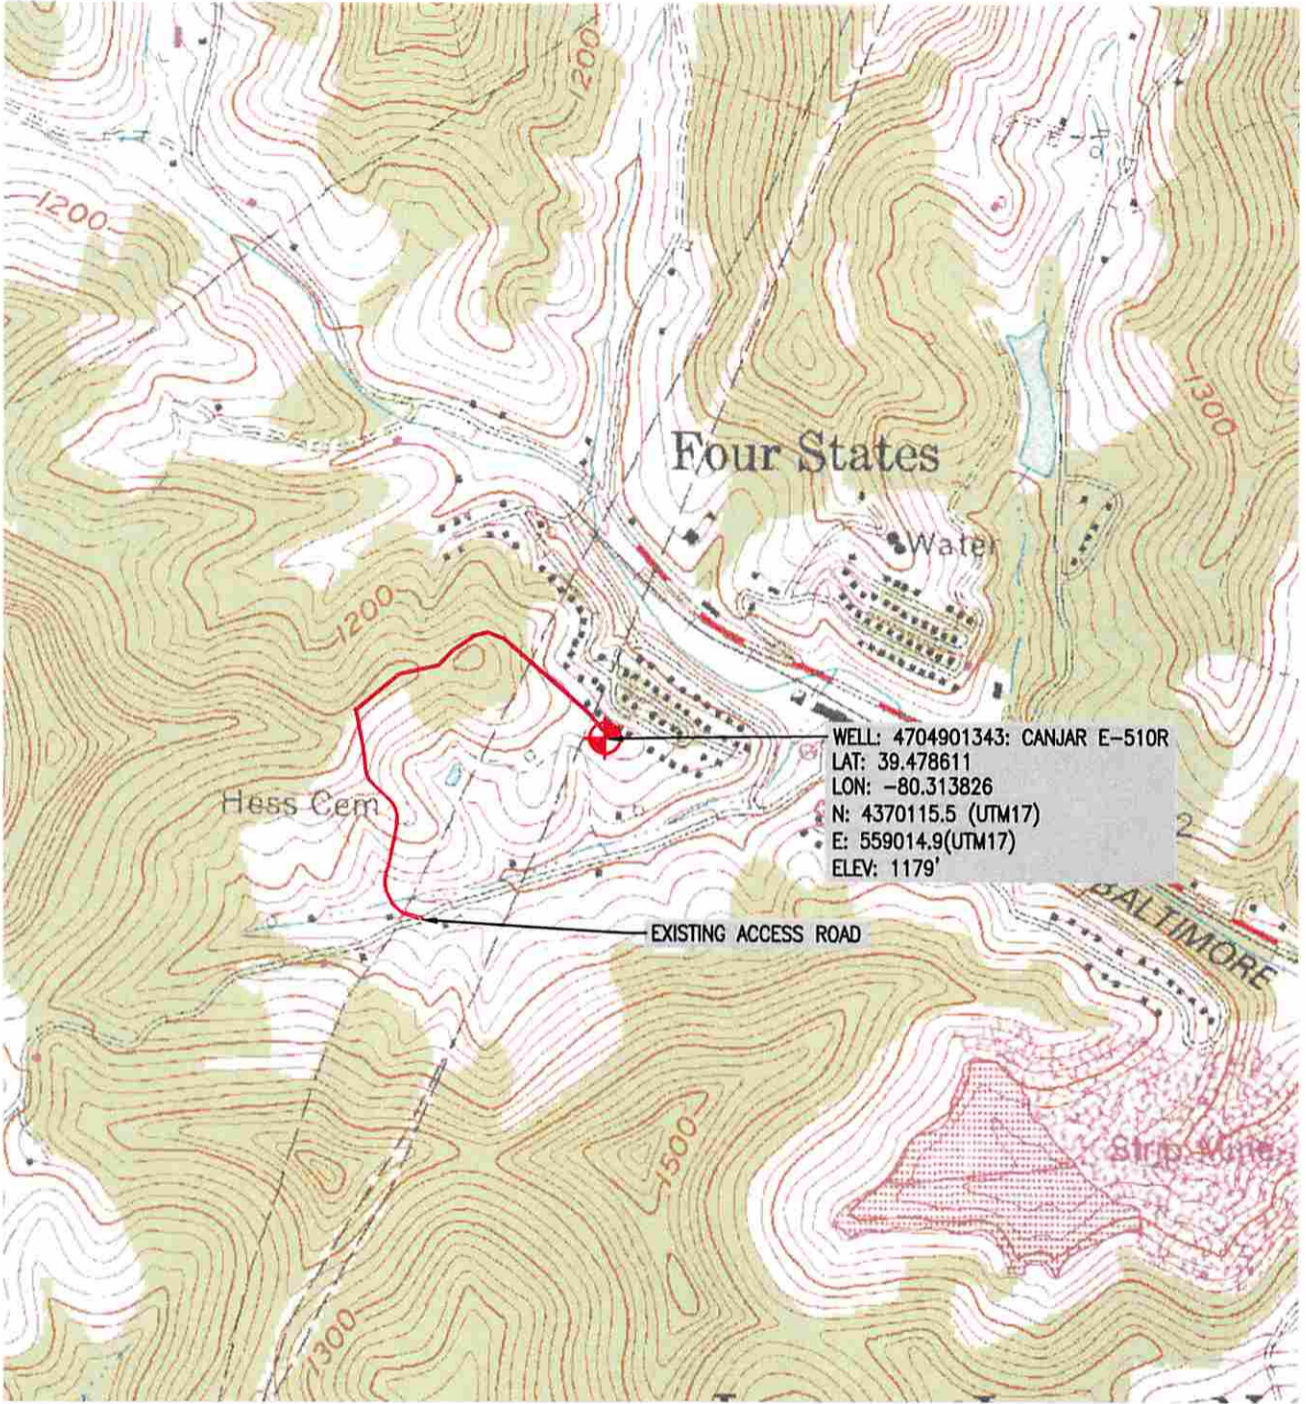


WSR
7-14-15

MAP REFERENCE: U.S.G.S. SHINNSTON, WV



810 HOUSTON STREET
FORT WORTH, TX 76102

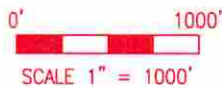

Voice: (724) 635-0210

TRI-COUNTY ENGINEERING, LLC

An ENERCON Company
319 Paintersville Road
Hunker, PA 15639
www.tricountyeng.com

Fax: (724) 635-0676



LOCATION MAP	
CANJAR E-510R WELL PLUG	
DRAWN BY: ZJC	LINCOLN DISTRICT, MARION COUNTY, WEST VIRGINIA
DATE: 6/8/2015	SHEET: 1 OF 1
SCALE: AS NOTED	FILE NO. OG61-17

JUL 20 2015 08/07/2015